

T08N-R02W-17_0000_MCS

Ho. 812-825-2992
Wk. 812-855-0996


Lee Barnes


Horses - Sewing



P.O. Box 3121, Bloomington, IN 47402

7

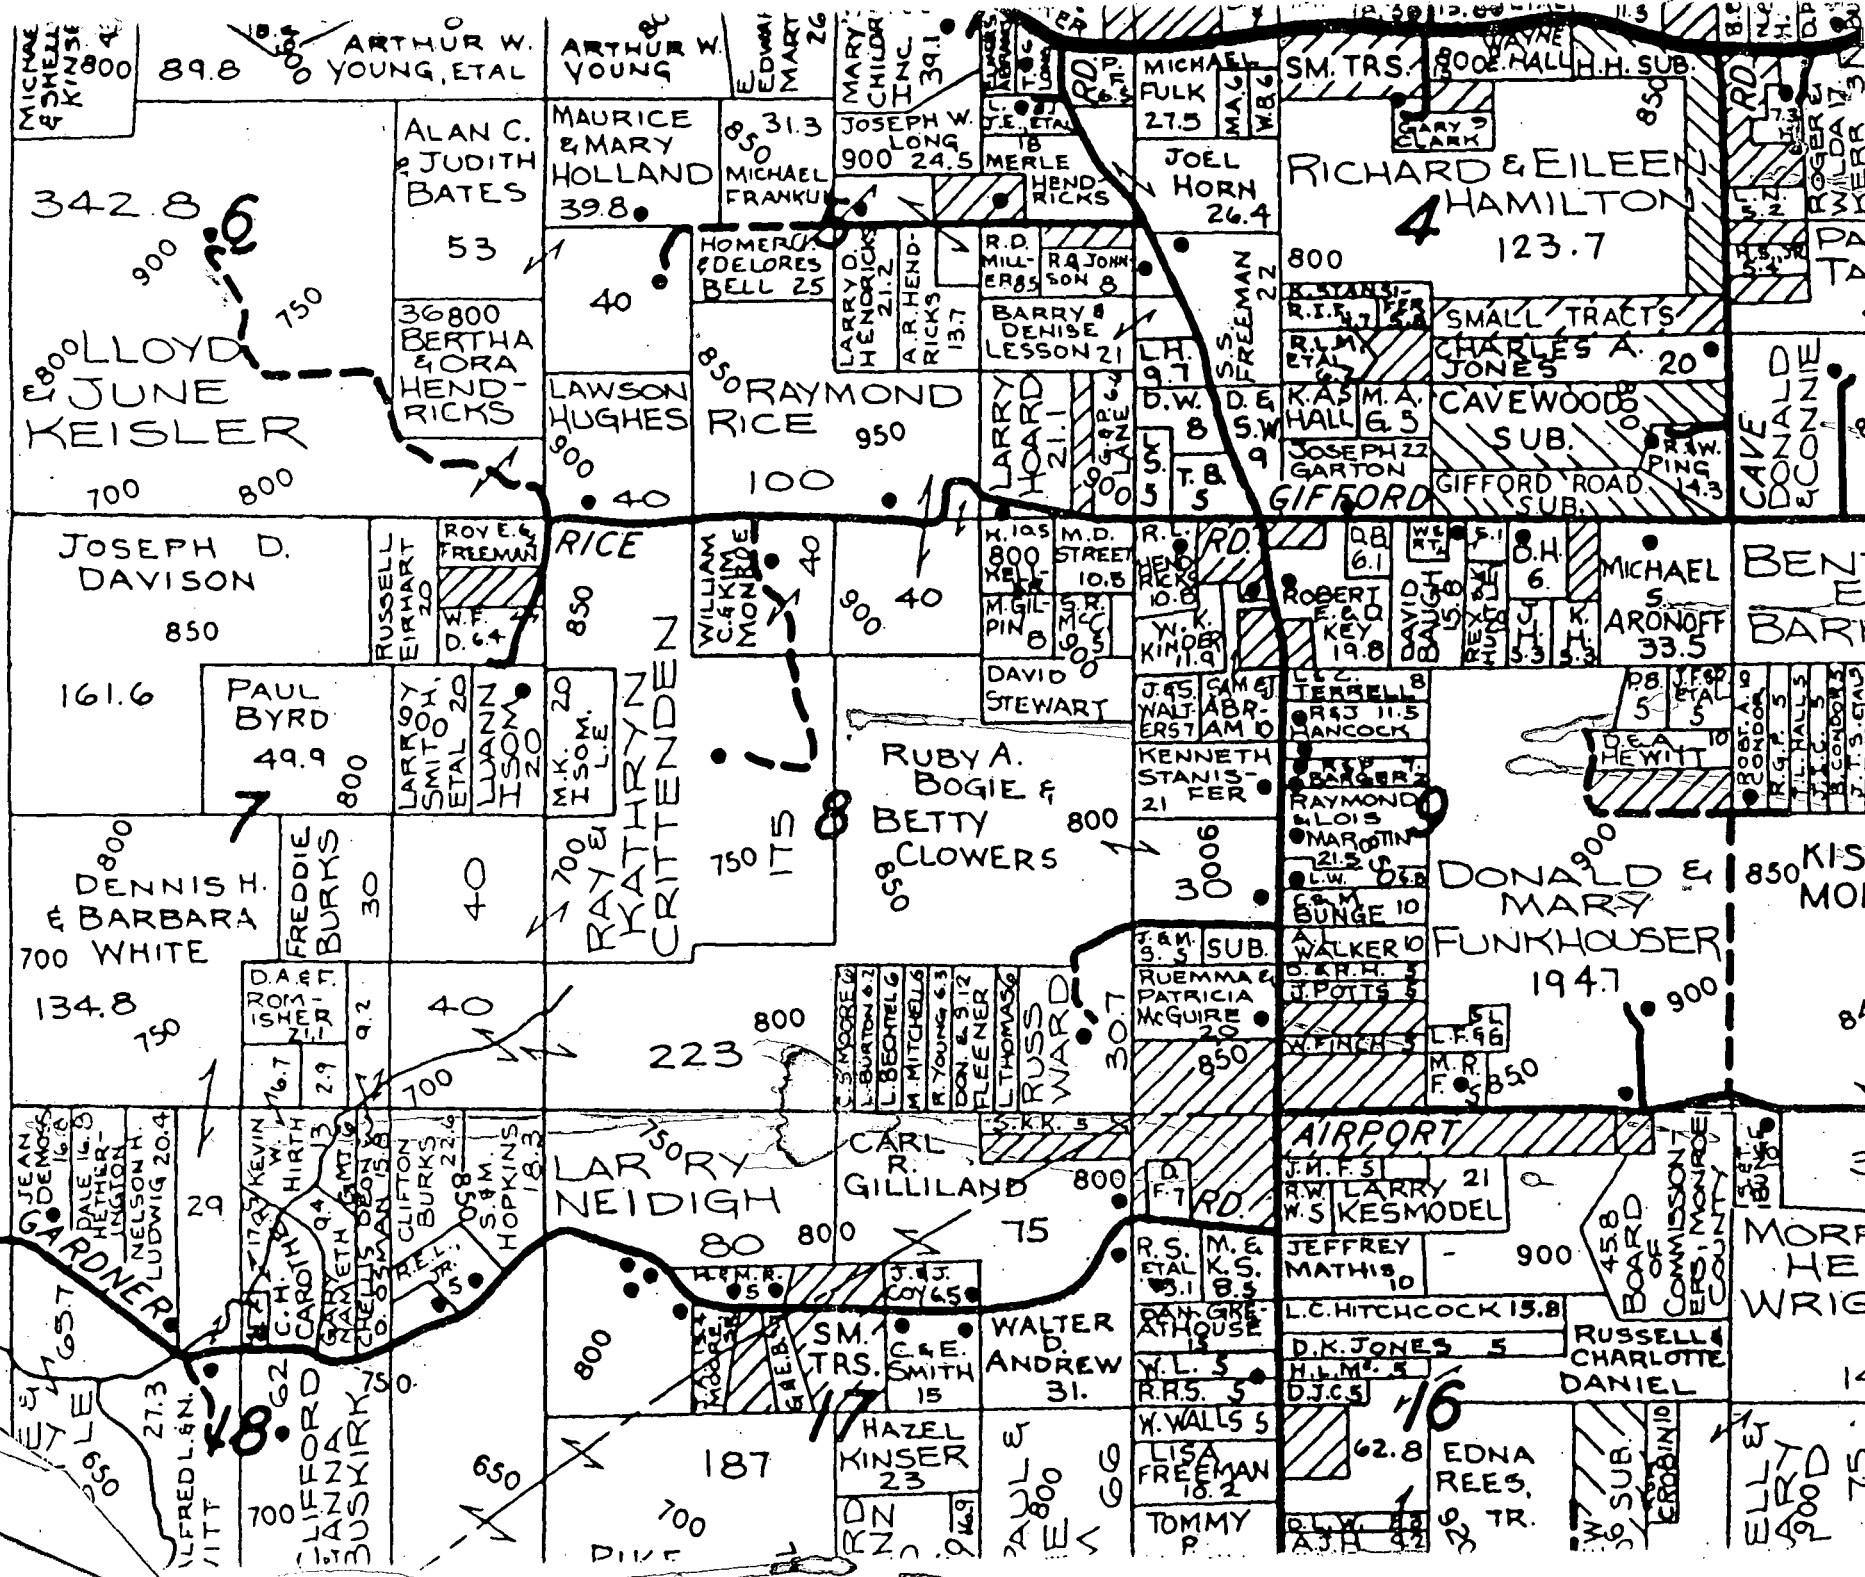

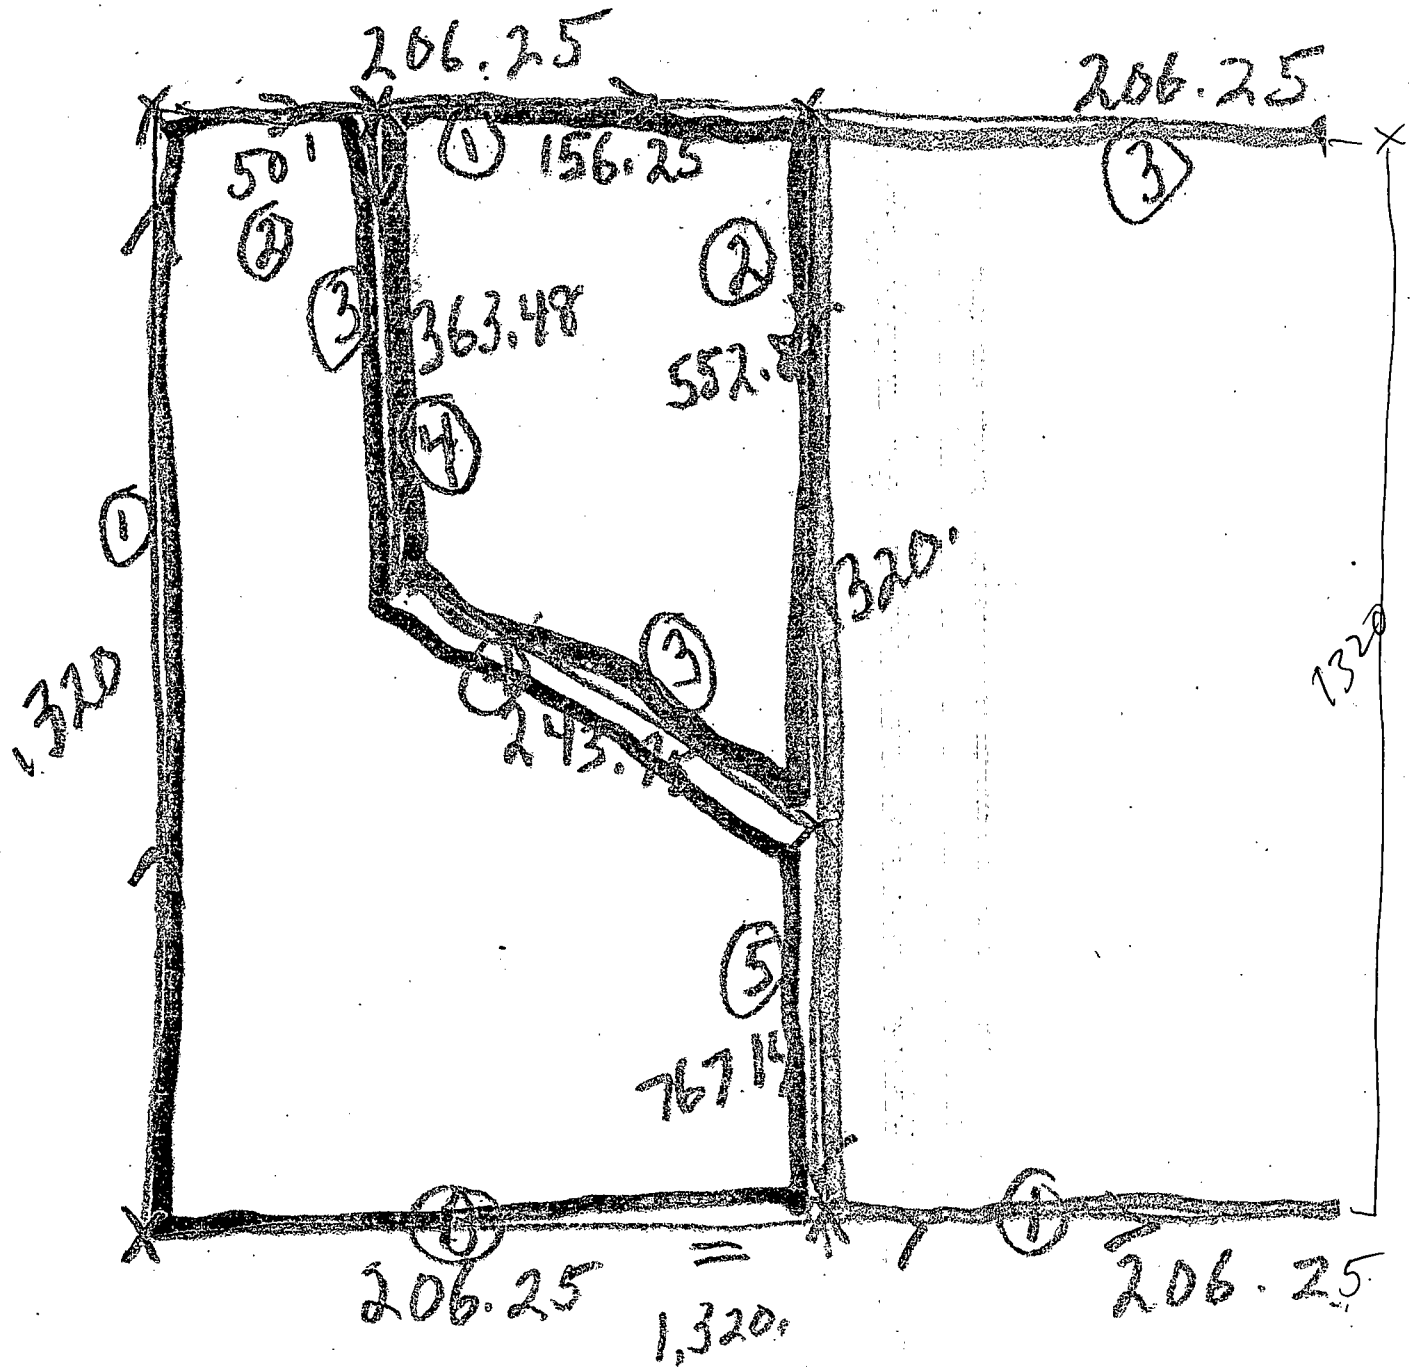

COPY

Mail tax bills to: 8273 W. Spicer Lane, Bloomington, Indiana
47403
Tax Duplicate: 016-03660-00

Warranty Deed

THIS INDENTURE WITNESSETH that


LARRY W. BURTON, an adult, of Monroe County, in the State of Indiana, CONVEYS AND WARRANTS to

S. LEE BARNES, an adult, of Monroe County, in the State of Indiana, for and in consideration of Ten Dollars (\$10.00) and other valuable considerations, the receipt of which is hereby acknowledged, the following real estate in Monroe County, Indiana, to-wit:

A part of the South half of the Southeast quarter of Section Eight (8) Township Eight (8) North, Range Two (2) West, in Monroe County, Indiana, bounded and described as follows, to-wit: Beginning at a point that is 206.25 feet East of the South West corner of the South East Quarter of said Section 8, thence East for 206.25 feet, thence North for 1320.00 feet, thence West for 206.25 feet, thence South for 1320.00 feet and to the point of beginning. Containing 6.25 acres more or less.

Subject to the first installment of Real Estate Taxes for the year 1998, due May, 1999, and all subsequent taxes.

IN WITNESS WHEREOF, The Grantor has hereunto set his hand and seal this 30th day of April, 1998.

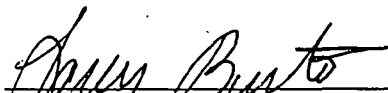
LARRY W. BURTON

STATE OF INDIANA, COUNTY OF MONROE, SS:

Before me, the undersigned, a Notary Public in and for said County and State, this 30th day of April, 1998, personally appeared LARRY W. BURTON, an adult, who acknowledged the execution of the foregoing Deed. In Witness whereof, I have hereunto subscribed my name and affixed my official seal.


My commission expires:
07-29-2000



Karen E. Newton

Notary Public Greene
Residing in Monroe County, IN

Instrument prepared by Daniel C. Stewart, Attorney (file #98291)

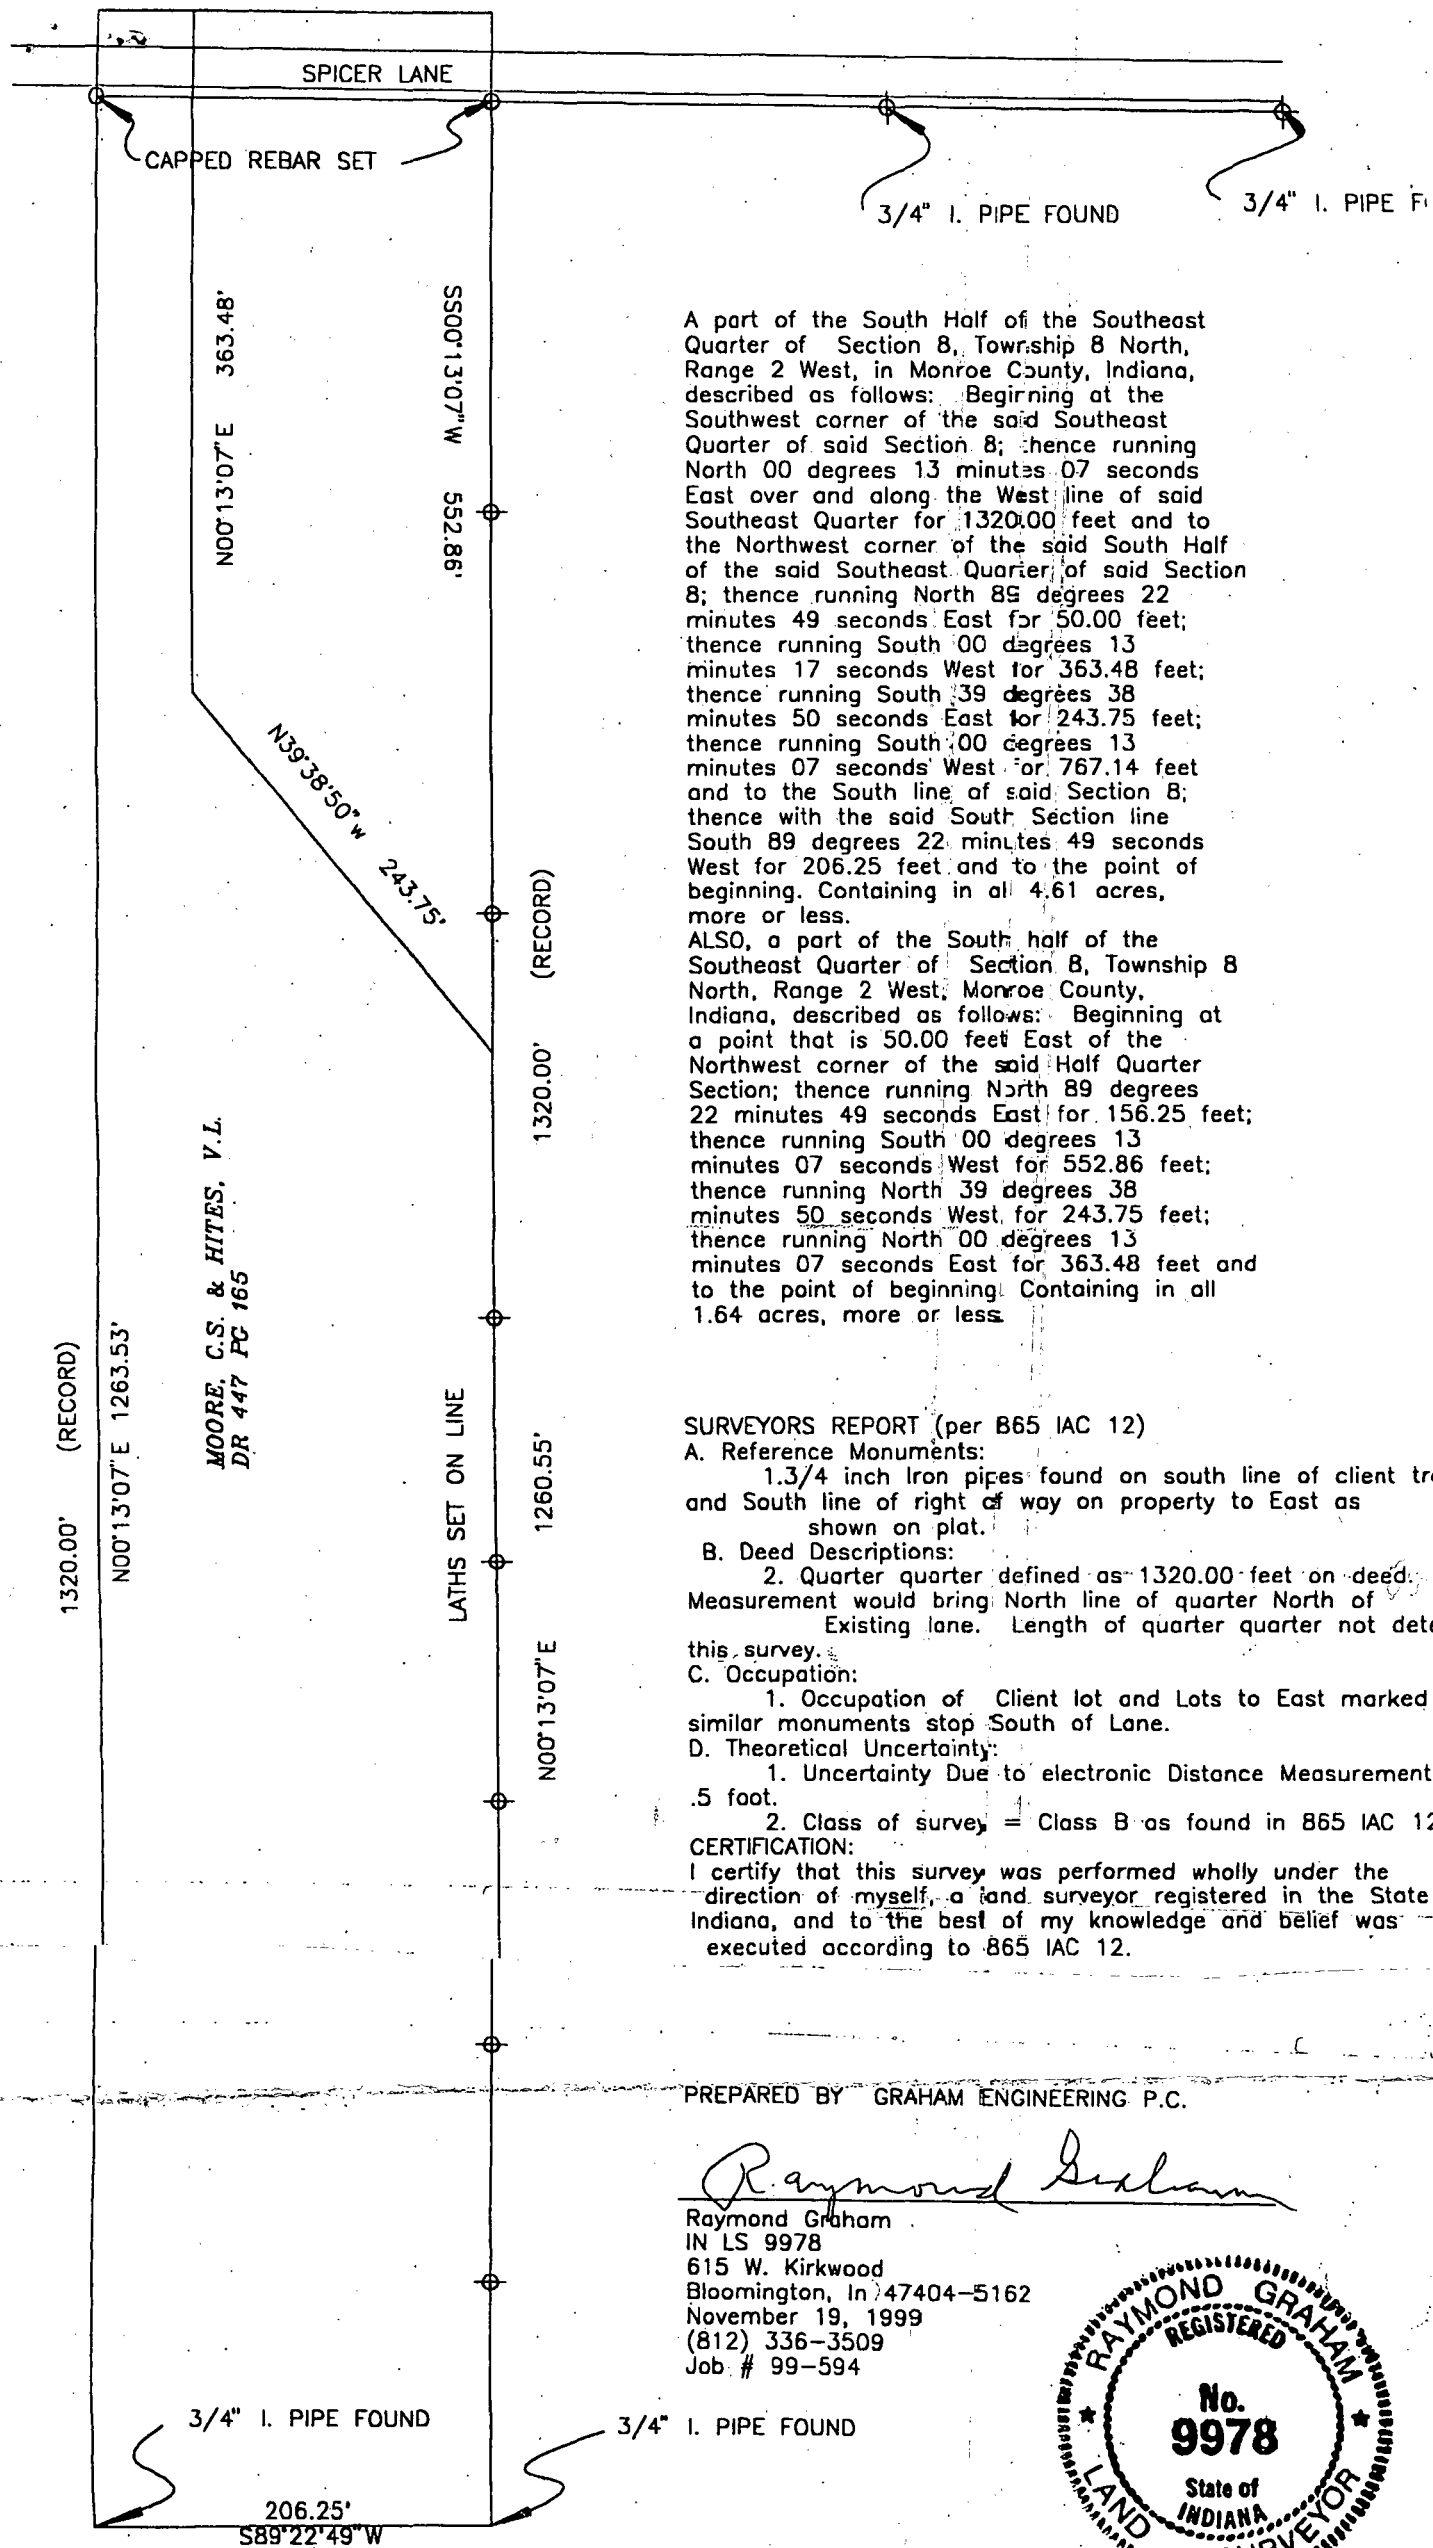

A part of the South Half of the Southeast Quarter of Section 8, Township 8 North, Range 2 West, in Monroe County, Indiana, described as follows: Beginning at the Southwest corner of the said Southeast Quarter of said Section 8; thence running North 00 degrees 13 minutes 07 seconds East over and along the West line of said Southeast Quarter for 1320.00 feet and to the Northwest corner of the said South Half of the said Southeast Quarter of said Section 8; thence running North 89 degrees 22 minutes 49 seconds East for 50.00 feet; thence running South 00 degrees 13 minutes 17 seconds West for 363.48 feet; thence running South 39 degrees 38 minutes 50 seconds East for 243.75 feet; thence running South 00 degrees 13 minutes 07 seconds West for 767.14 feet and to the South line of said Section 8; thence with the said South Section line South 89 degrees 22 minutes 49 seconds West for 206.25 feet and to the point of beginning. Containing in all 4.61 acres, more or less.

ALSO, a part of the South half of the Southeast Quarter of Section 8, Township 8 North, Range 2 West, Monroe County, Indiana, described as follows: Beginning at a point that is 50.00 feet East of the Northwest corner of the said Half Quarter Section; thence running North 89 degrees 22 minutes 49 seconds East for 156.25 feet; thence running South 00 degrees 13 minutes 07 seconds West for 552.86 feet; thence running North 39 degrees 38 minutes 50 seconds West for 243.75 feet; thence running North 00 degrees 13 minutes 07 seconds East for 363.48 feet and to the point of beginning. Containing in all 1.64 acres, more or less.

SURVEYORS REPORT (per B65 IAC 12)

A. Reference Monuments:

1. 3/4 inch Iron pipes found on south line of client tract and South line of right of way on property to East as shown on plat.

B. Deed Descriptions:

2. Quarter quarter defined as 1320.00 feet on deed. Measurement would bring North line of quarter North of Existing lane. Length of quarter quarter not determined by this survey.

C. Occupation:

1. Occupation of Client lot and Lots to East marked similar monuments stop South of Lane.

D. Theoretical Uncertainty:

1. Uncertainty Due to electronic Distance Measurement .5 foot.


2. Class of survey = Class B as found in B65 IAC 12

CERTIFICATION:
I certify that this survey was performed wholly under the direction of myself, a land surveyor registered in the State of Indiana, and to the best of my knowledge and belief was executed according to B65 IAC 12.

PREPARED BY GRAHAM ENGINEERING P.C.

Raymond Graham
Raymond Graham
IN LS 9978
615 W. Kirkwood
Bloomington, IN 47404-5162
November 19, 1999
(812) 336-3509
Job # 99-594



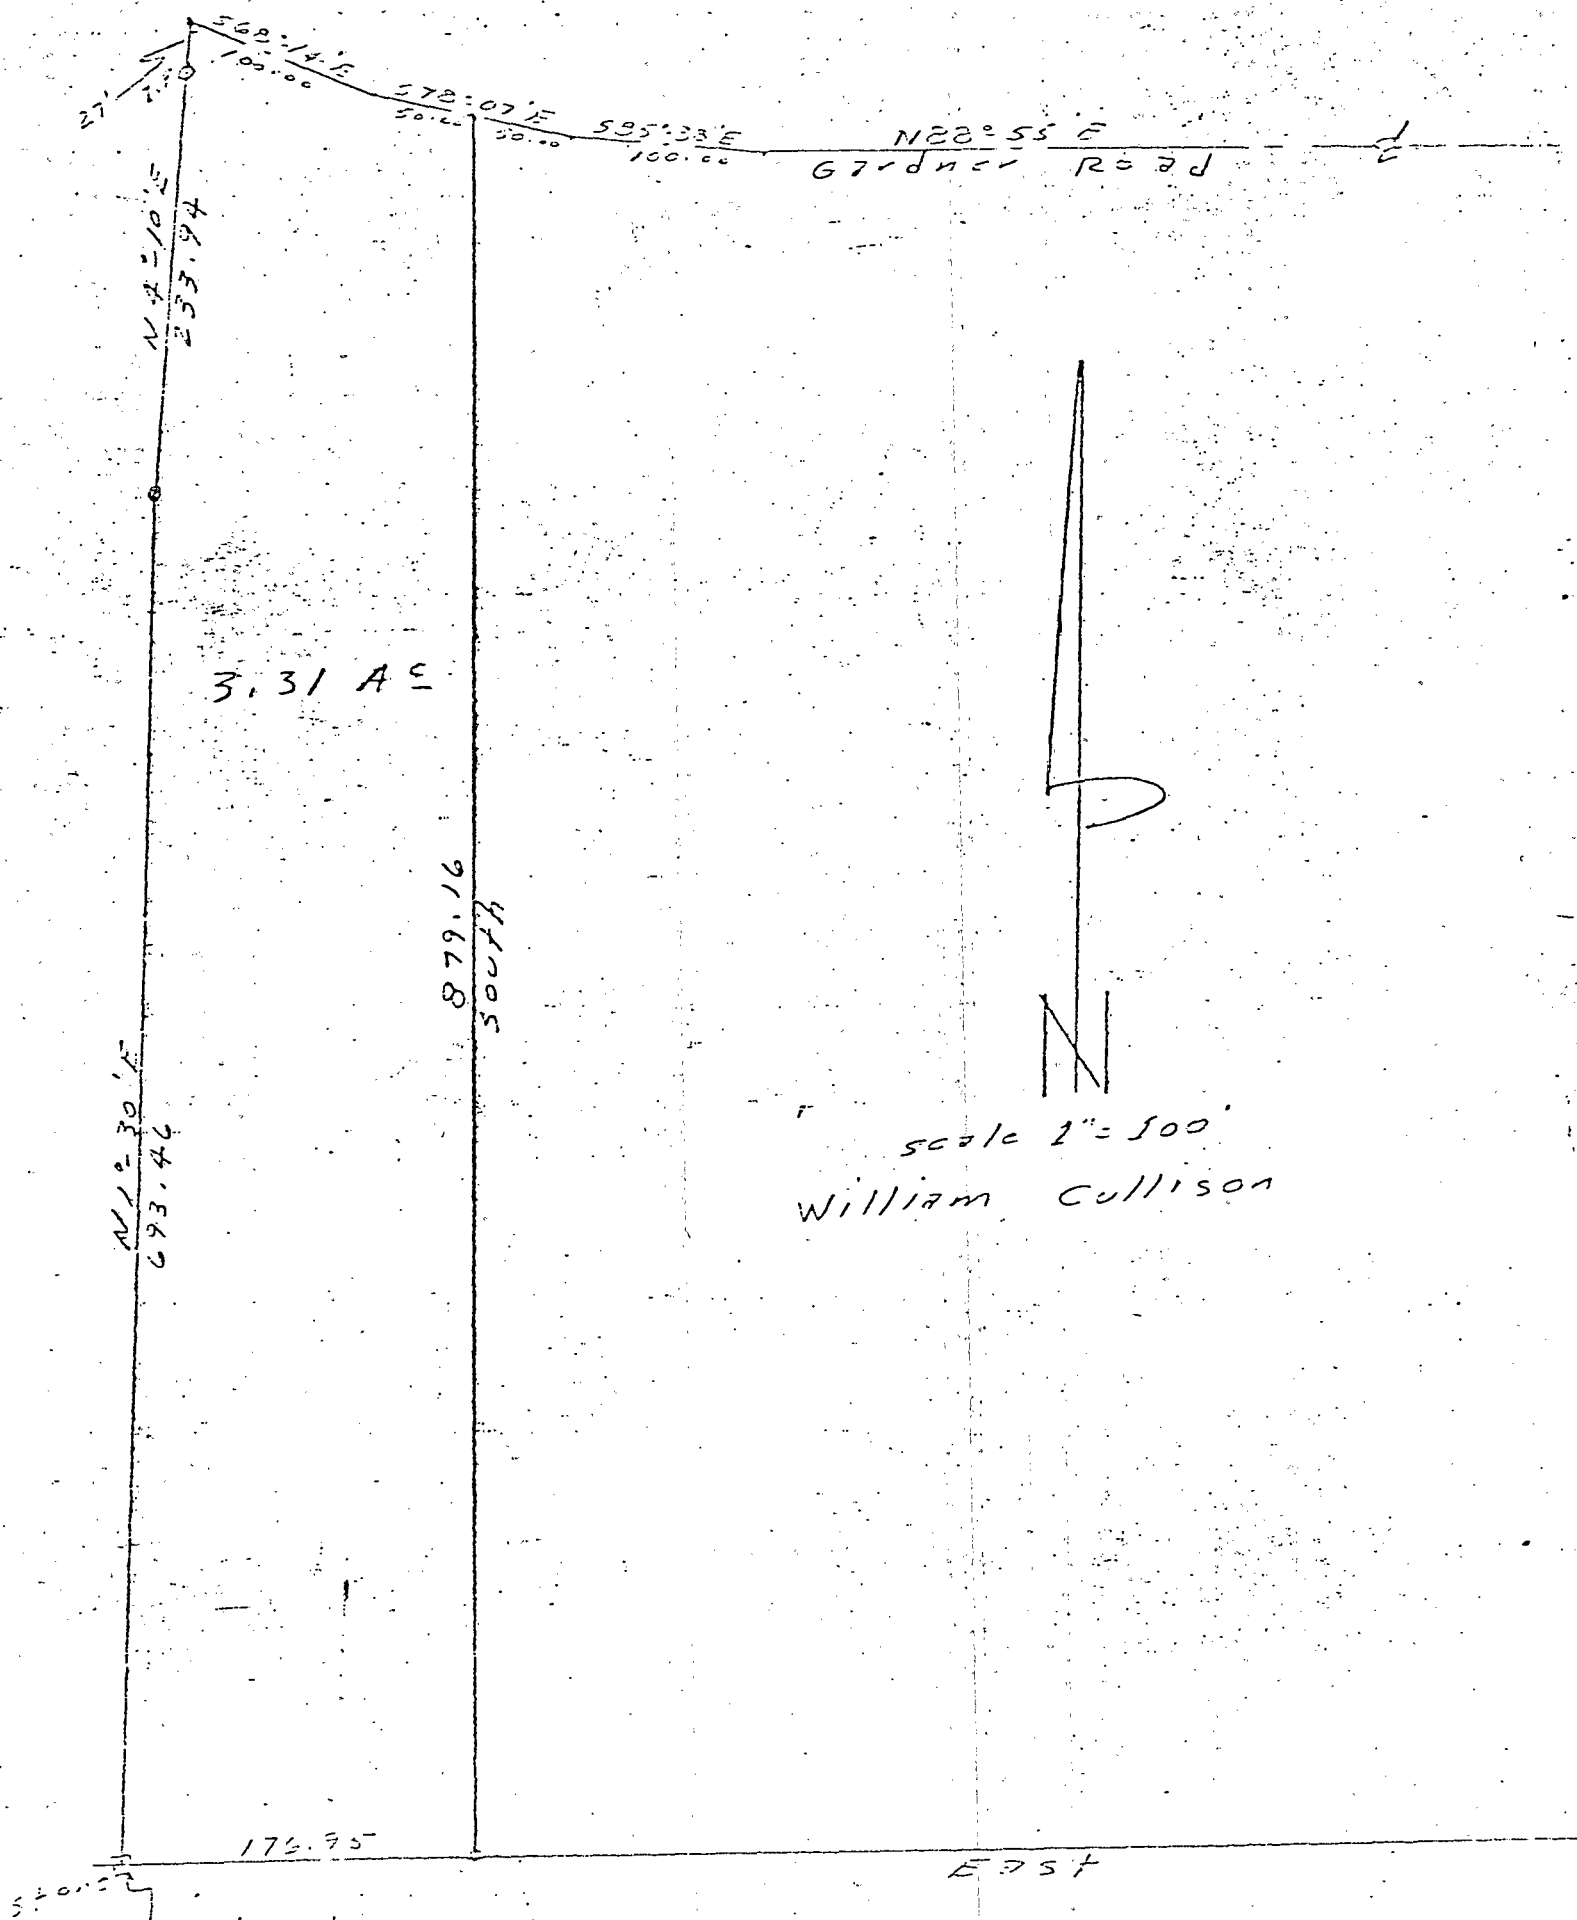

southwest corner
 south ^{EAST} quarter
 north ^{EAST} quarter
 section 17, Township 3 North
 Range 2 West

Legal Description

A part of the southeast quarter of the Northwest quarter of section 17, Township 3 North, Range 2 West, Monroe County, Indiana, bounded and described as follows: Beginning at the southwest corner of said southeast quarter of the Northwest quarter of section 17, Township 3 North, Range 2 West; thence North $1^{\circ}30'$ East for 693.46 Ft.; thence North $4^{\circ}10'$ East for 253.94 Ft.; and to the centerline of the Gardner Road; thence with the centerline of said Gardner Road and running South $68^{\circ}14'$ East for 100.00 Ft.; thence South $78^{\circ}07'$ East for 50.00 Ft.; thence leaving the centerline of said road and running south for 379.16 Ft.; and to the south line of said southwest quarter of the Northwest quarter; thence West for 776.95 Ft. to the place of beginning; containing 3.31 Acres, more or less.

Van Buren Section 17
Cullison - Moore

William Cullison

A part of the northwest quarter of section 17, township 8 north, range 2 west, Monroe County, Indiana described as follows: Beginning at the southeast corner of the south west quarter of the said northwest quarter, thence north 1 degree 30 minutes east for 693.46 feet, thence north 4 degrees 10 minutes east for 233.94 feet to the centerline of Gardner road, thence along the road centerline the following directions and dimensions, to wit: north 50 degrees 34 minutes west for 77.00 feet, thence north 47 degrees 13 minutes west for 80.00 feet, thence north 42 degrees 50 minutes 30 seconds west for 300.00 feet; thence leaving the road centerline and running south 1 degree 57 minutes west for 624.00 feet, thence west for 116.50 feet, thence south 1 degree 57 minutes west for 624.00 feet, thence east for 453.40 feet and to the point of beginning. Containing in all 10.00 acres, more or less.

REAL ESTATE TRANSFER

REC'D 14 1977

John W. Davis
Auditor Monroe County, Ind.



R 24
Recorded Graham
R25 # 8409 Indiana

Wm. Brown

A part of the Southwest quarter of the Northeast quarter and a part of the Southeast quarter of the Northwest quarter, all in Section 17, Township 5 North, Range 2 West, bounded and described as follows:

Beginning at the center of said section 17; thence running West 150.0 feet; thence running East 150.0 feet; thence running North 290.40 feet and to the center of said road 150.0 feet; thence leaving said road and running South 290.40 feet and to the place of beginning, containing 1.0 acre.

LEGAL DESCRIPTION

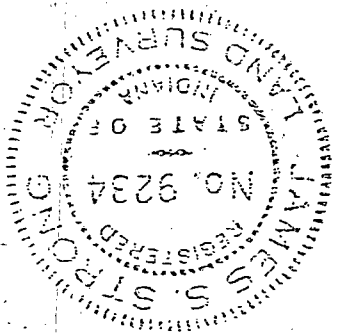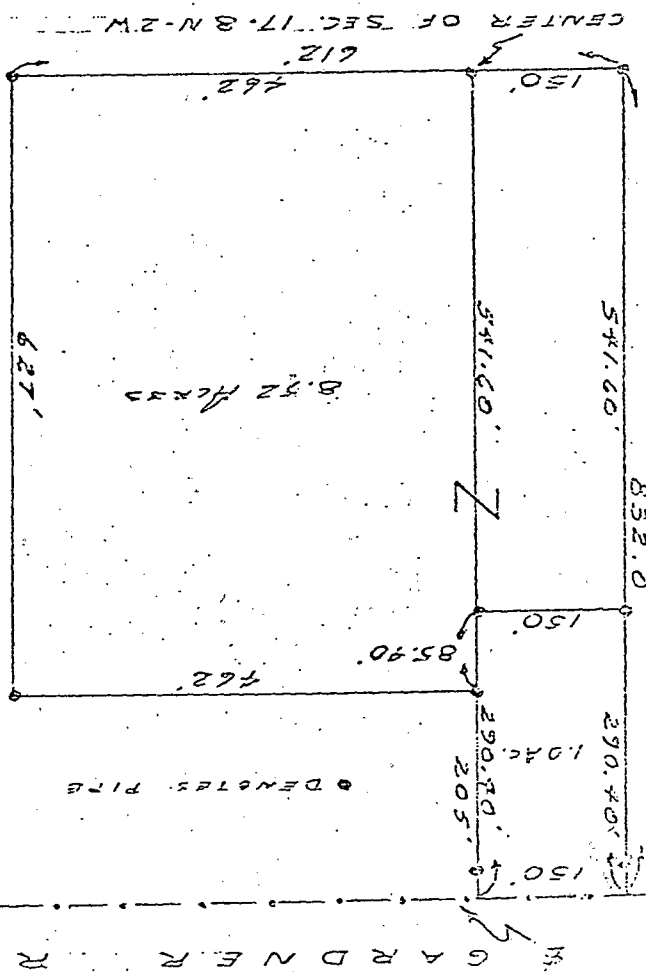

James S. Strong
James S. Strong
Reg. No. 9234

CERTIFICATE OF SURVEY

This is to certify that this is a true and accurate representation of a survey completed by me May 11, 1971

Wm. Brown


LEE UTT
REGISTERED LAND SURVEYOR NO. 50089, INDIANA
OFFICE PHONE 332-6366 HOME PHONE 825-5961
1804 SOUTH HENDERSON
BLOOMINGTON, INDIANA 47401


April 24, 1979

Legal description:


Steve Dodds

A part of the Southeast quarter of the Northwest quarter of Section 17, Township 8 North, Range 2 West, Monroe County, Indiana, bounded and described as follows:
Beginning at a point on the North line of said quarter quarter Section, said point of beginning being 77 feet West of the North-east corner of said Southeast quarter of the Northwest quarter; thence from said point of beginning and with the north line of said quarter quarter Section and running North 89°-16'-20" West for 233.62 feet; thence leaving said north line and running South 00°-22'-35" West for 481.19 feet and to the centerline of Gardner Road; thence with the centerline of said road and running South 89°-43'-30" East for 236.30 feet and to a point that is 77 feet West of the East line of said quarter quarter Section; thence leaving the centerline of said road and running North 00°-03'-19" East for 479.34 feet and to the point of beginning. Containing 2.59 acres, more or less.

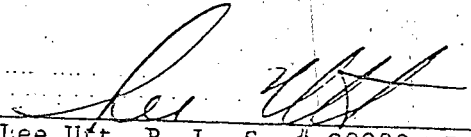
Lee Utt, R. L. S. # S0089, Indiana

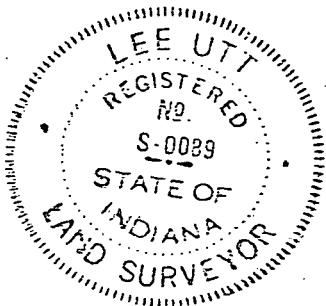

*Monroe County, Indiana
Section 17
Gardner to Dodds*

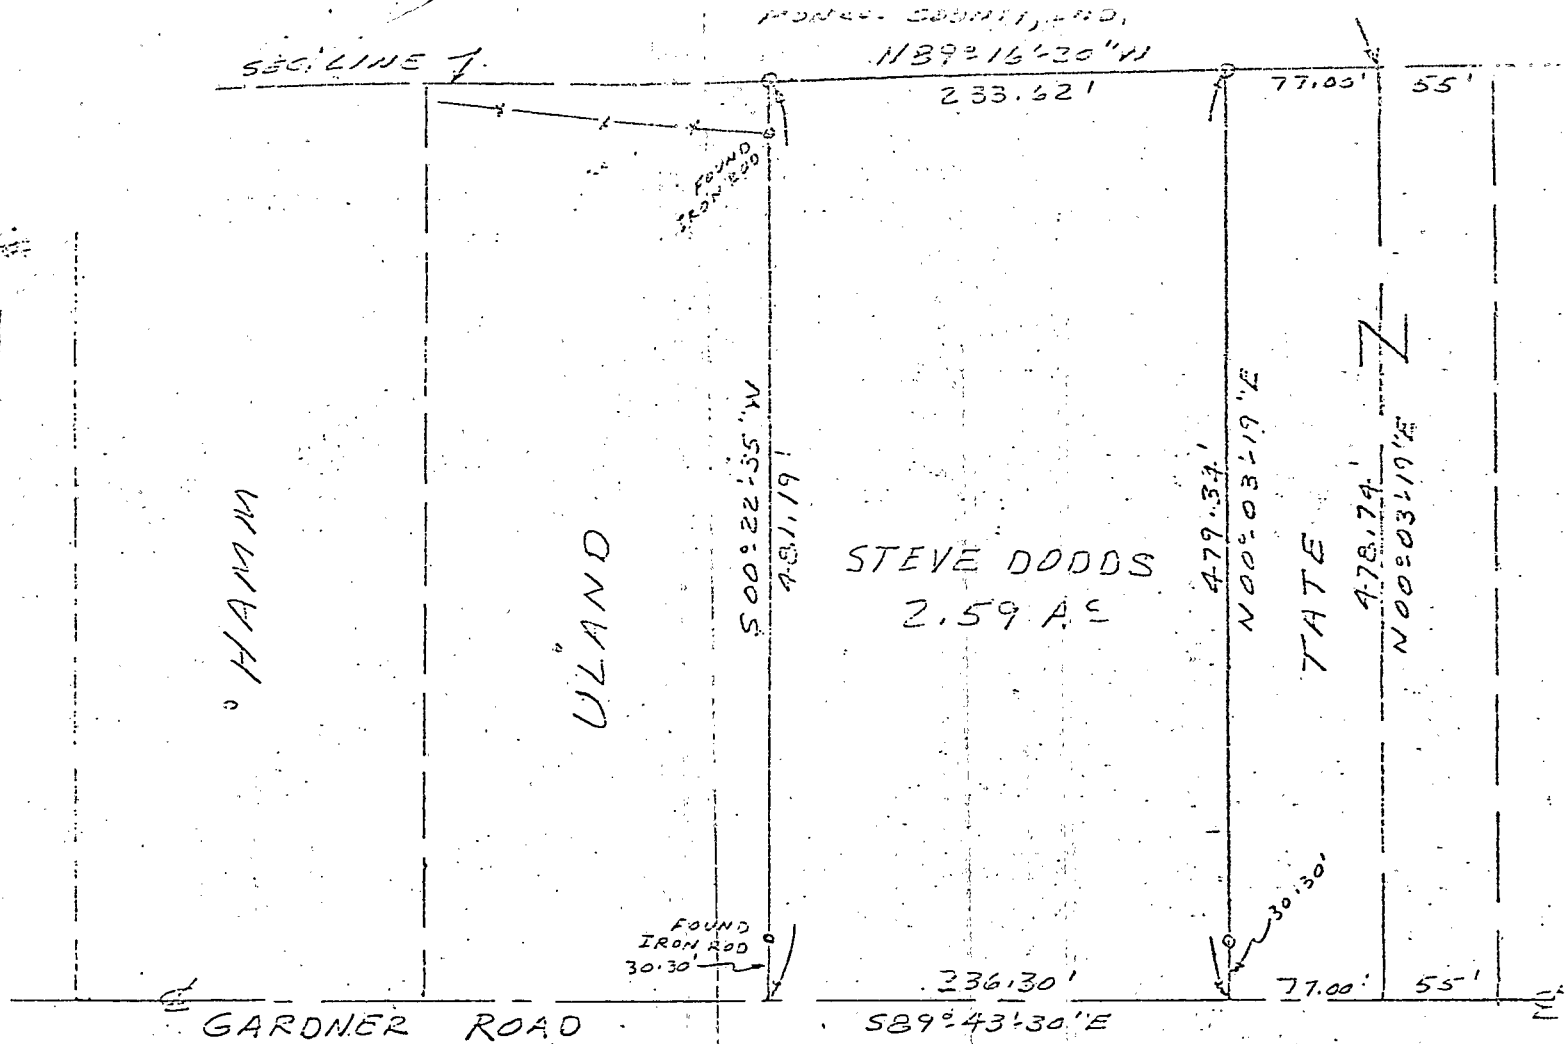


N

SCALE 1"=100'

State of Indiana
County of Monroe SS:

I, Lee Utt, hereby certify that I am a Land Surveyor licensed in compliance with the laws of the State of Indiana; that the above plat and attached description correctly represents a survey completed by me on April 24, 1979; that all monuments shown thereon actually exist; and that their location and type are, to the best of my knowledge, accurately shown.

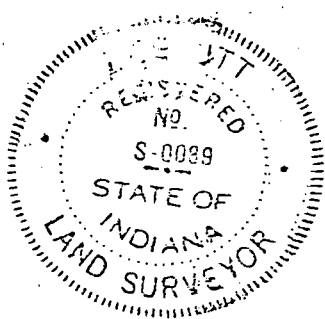


Lee Utt
Lee Utt, R. L.S. # S0089, Indiana
1604 South Henderson St.
Bloomington, Indiana 47401


FILED

APR 2 1979

Monroe County, Indiana

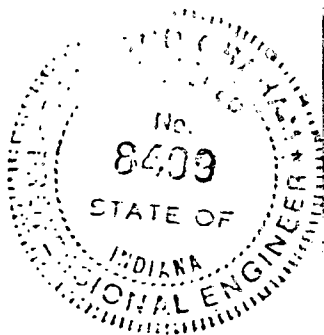

SCALE
1"=100'
1.914 ACRES

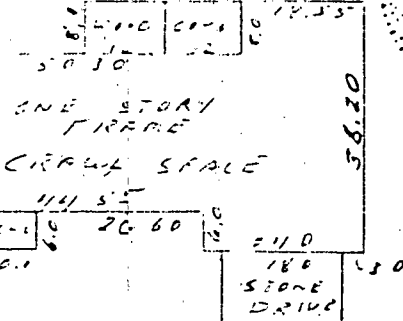

HOUSE DETAIL
1"=30'

Raymond Graham


Raymond Graham
R.P.E. 8409 Indiana
3215 N. Smith Pike
Bloomington, Indiana
February 7, 1979

ENGINEER'S CERTIFICATION:

I hereby certify that this plat as shown is a true and complete survey of the described property, and further certify that all improvements are wholly within the boundaries of said described property, and that the said improvements do not encroach upon any other property, nor are there any encroachments from any other property on said surveyed property.

DESCRIPTION:

A part of the Southeast quarter of the Northwest quarter of Section 17, Township 8 North, Range 2 West, Van Buren Township, Monroe County, Indiana, More particularly described as follows:
Beginning at a nail in the physical centerline of a county blacktop road known as Gardner Road, said nail being 344.00 feet, more or less, West of the East line of the Northwest quarter of aforesaid Section 17; thence North 00 degrees East (bearing assumed from the physical centerline of aforesaid Gardner Road being East-West) 30.00 feet to a 5/8 inch iron rod; thence continuing North 00 degrees East 443.23 feet to a 5/8 inch iron rod in an existing East-West fence; thence North 85 degrees 11 minutes 24 seconds West along said existing fence 173.86 feet to a 5/8 inch iron rod; thence South 00 degrees West 457.81 feet to a 5/8 inch iron rod; thence continuing South 00 degrees West 30.00 feet to a nail in the physical centerline of aforesaid Gardner Road; thence North 90 degrees East along the physical centerline of said road 173.25 feet to the point of beginning. Containing 1.914 acres, more or less, subject to all legal right-of-way and easement.

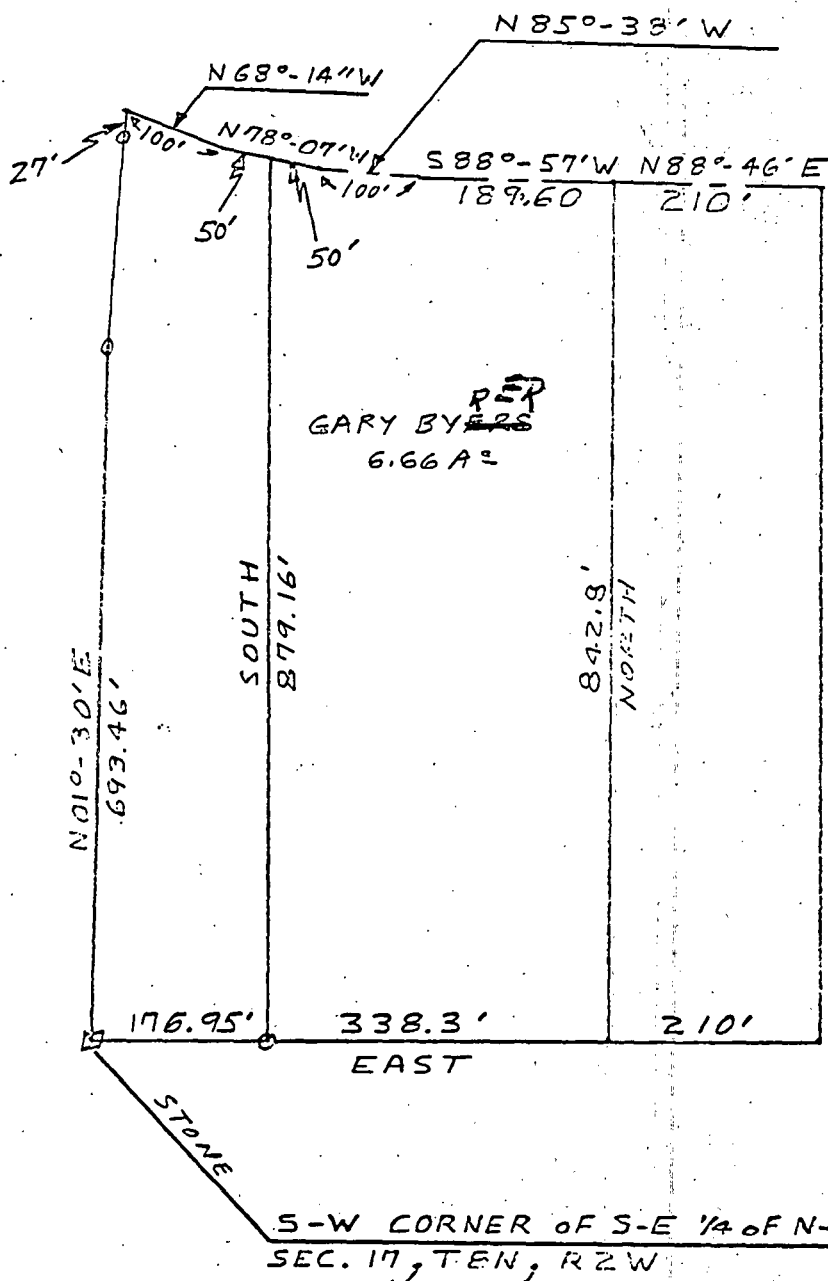

SCALE: 1"=200'


FILED
SEP 6 1981

V. Simpson
Auditor Monroe County, Indiana

Legal description:


A part of the Southeast quarter of the Northwest quarter of Section Seventeen (17), Township Eight (8) North, Range Two (2) West, in Monroe County, Indiana, bounded and described as follows, to-wit: Beginning at a point on the South line of said quarter quarter Section that is 176.95 feet East of the Southwest corner of said Southeast quarter of the Northwest quarter of said Section 17, Township 8 North, Range 2 West; thence with the South line of said quarter quarter Section and running East for a distance of 338.30 feet; thence leaving the South line of said quarter quarter Section and running North for a distance of 842.8 feet and to the centerline of the Gardner Road; thence with the centerline of said road South 88 degrees 57 minutes West for 189.60 feet; thence North 85 degrees 38 minutes West for 100 feet; thence North 78 degrees 07 minutes West for 50.00 feet; thence leaving the centerline of said road and running South for 879.16 feet and to the point of beginning. Containing 6.66 acres, more or less.

Subject to all easements and rights-of-way of record.

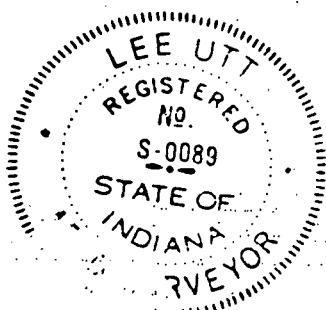

Lee Utt
Lee Utt, R. L. S. # S0089, Indiana
1604 South Henderson St.
Bloomington, Indiana 47401
July 10, 1981

10-30-80 Gilliland to Gilliland

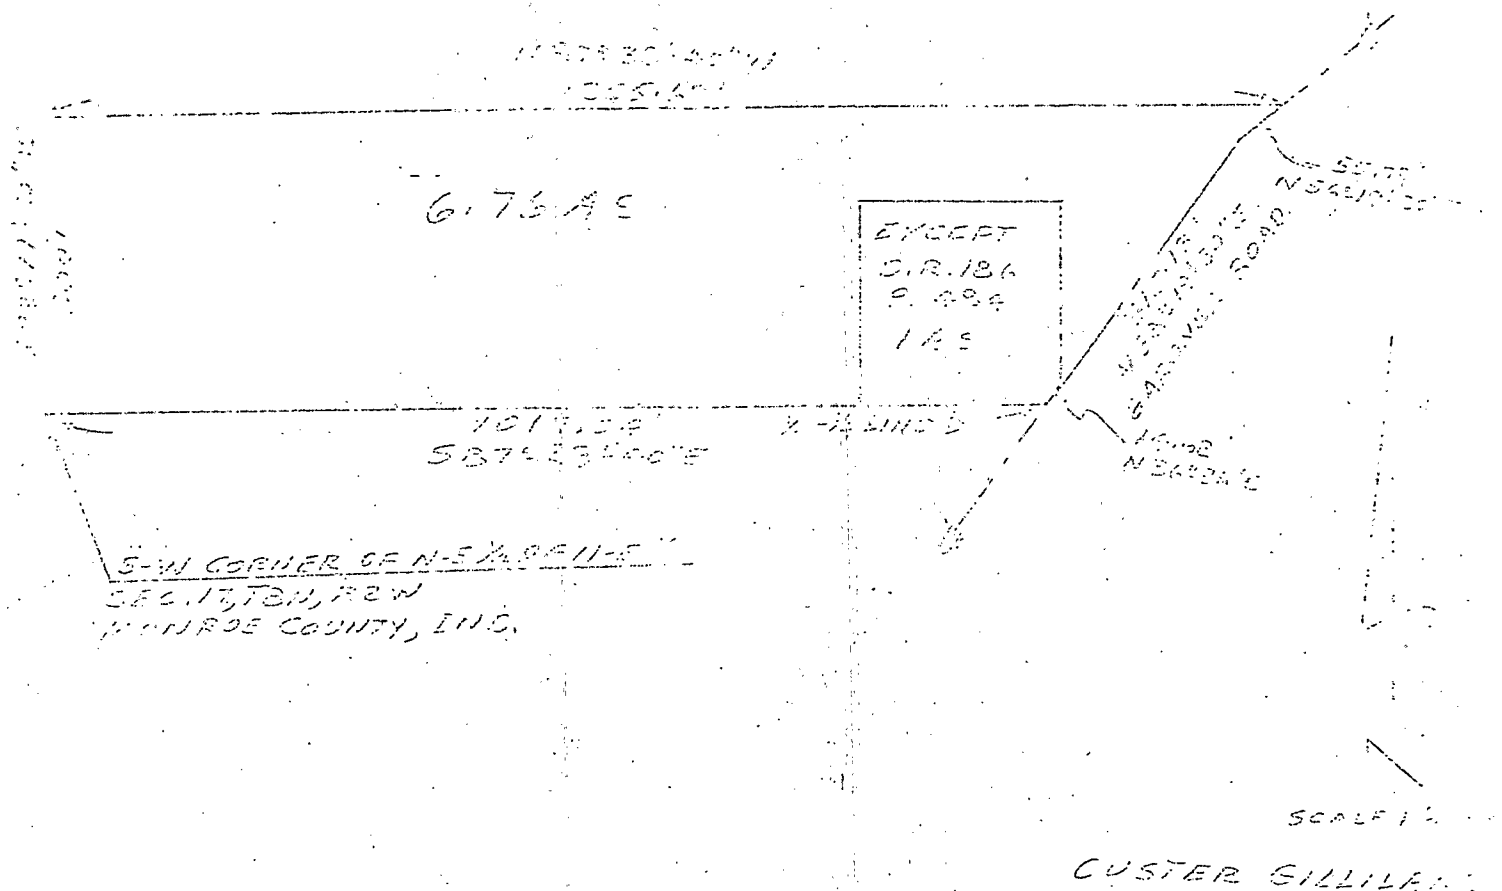

Legal description:

A part of the Northeast quarter of the Northeast quarter of Section 17, Township 8 North, Range 2 West, Monroe County, Indiana, bounded and described as follows:


Beginning at the Southwest corner of said Northeast quarter of the Northeast quarter; thence from said point of beginning and with the South line of said quarter section and running South 87°-38'-40" East for 1017.04 feet, and to the centerline of Gardner Road; thence leaving said South line and with the centerline of said road and running North 36°-36' East for 14.68 feet; thence North 38°-19'-30" East for 315.13 feet; thence North 36°-19'-30" East for 55.79 feet; thence leaving the centerline of said road and running North 87°-38'-40" West for 1255.68 feet and to the point of beginning. Containing 7.76 acres, more or less.

Except, a one acre tract of land that is described in a deed from Custer Gilliland to Carl R. and Rebecca J. Gilliland and recorded October 26, 1968 in Deed Record 186, page 484, in the office of the Recorder of Monroe County, Indiana.

Containing in the total of the above described tract, after said exception 6.76 acres, more or less.

*thence South 02° 19' 20" West for 300 feet

Lawyer, R. L. S. & SCOTT, Indiana
1504 South Henderson St.
Bloomington, Indiana 47401
September 29, 1980

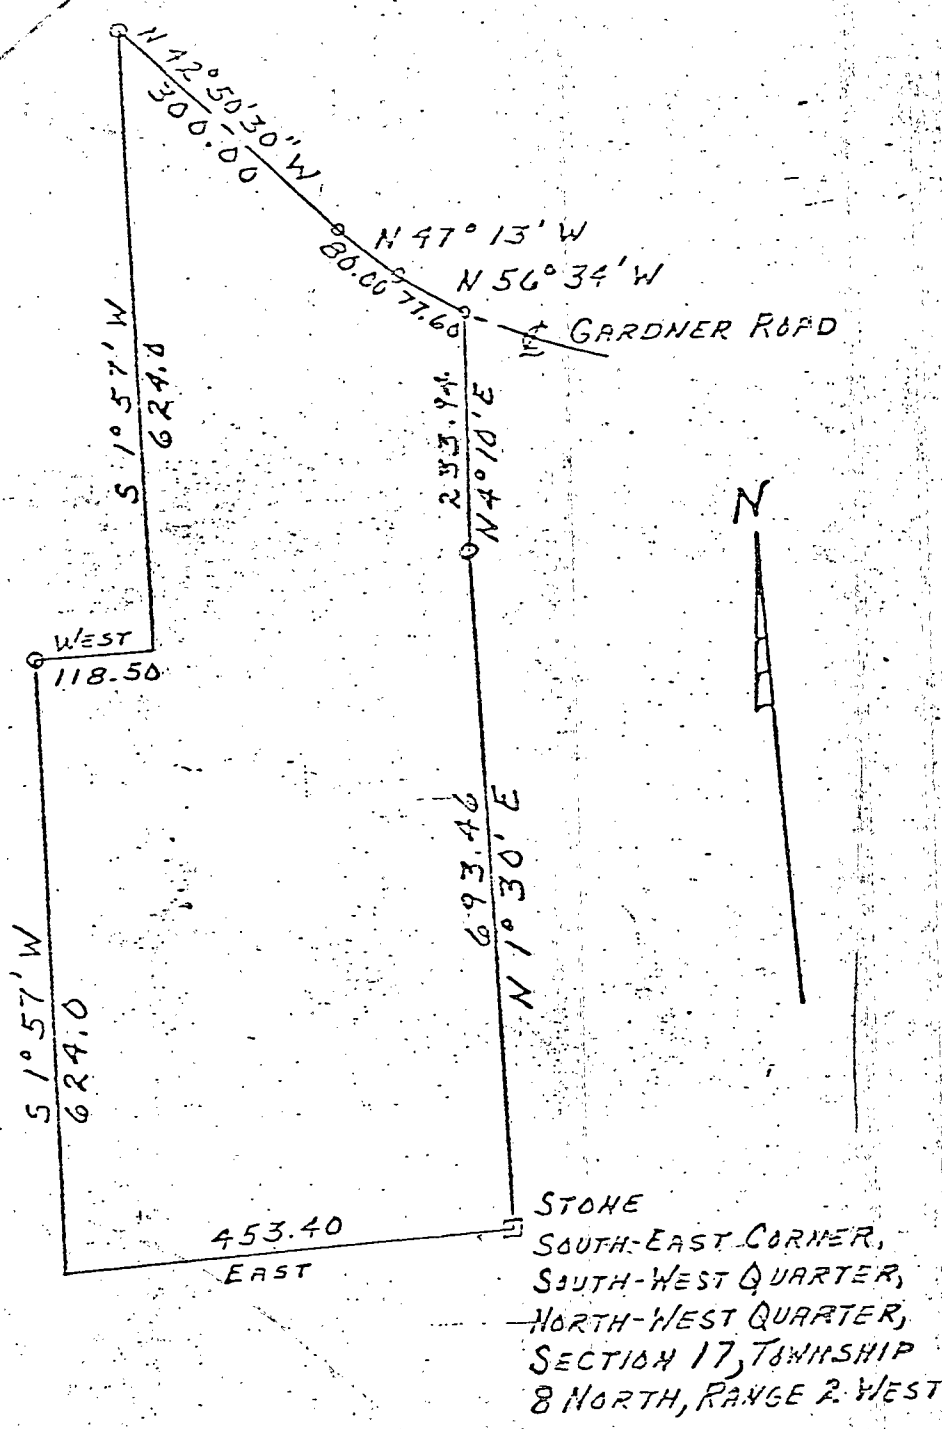

WILLIAM CULLISON
MONROE COUNTY, INDIANA
SCALE: 1" = 200'
DATE: JULY 31, 1967

RAYMOND GRAHAM
RPE #8409 INDIANA


18 17 Stone set Sect 17 T8N R2W
Stone
19 20 2643.96 5880 31'18" E 2636.04 RR Spike in Road
Sect 20 T8N R2W


Legal description:

Gilliland

A part of the Northeast quarter of Section 17, Township 8 North, Range 2 West, Monroe County, Indiana, bounded and described as follows: Beginning at a set 5/8 inch iron pin marking the Northwest corner of said Northeast quarter; thence from said point of beginning and with the North line of said Section 17 and running South 88 degrees 41 minutes 54 seconds East for 1540.20 feet and to a set 5/8 inch iron pin; thence South 00 degrees 17 minutes 47 seconds West for 436.00 feet and to a set 5/8 inch iron pin; thence South 88 degrees 41 minutes 54 seconds East for 1100.00 feet and to a point on the East line of said Section 17, passing a set 5/8 inch iron pin at 1085.00 feet; thence with the East line of Section 17 and running South 00 degrees 17 minutes 47 seconds West for 510.72 feet and to a found railroad spike in the centerline of Gardner Road; thence with the centerline of Gardner Road and running South 62 degrees 34 minutes 14 seconds West for 52.52 feet; thence South 48 degrees 11 minutes 55 seconds West for 86.02 feet; thence South 36 degrees 08 minutes 27 seconds West for 661.48 feet; thence South 57 degrees 47 minutes 19 seconds West for 35.60 feet; thence South 65 degrees 19 minutes 12 seconds West for 92.33 feet; thence 72 degrees 08 minutes 13 seconds West for 99.50 feet; thence South 75 degrees 08 minutes 12 seconds West for 120.50 feet; thence South 80 degrees 18 minutes 32 seconds West for 258.66 feet; thence South 83 degrees 47 minutes 16 seconds West for 97.52 feet; thence South 87 degrees 07 minutes 53 seconds West for 148.14 feet and to a found railroad spike; thence leaving the centerline of Gardner Road and running North 00 degrees 21 minutes 25 seconds East for 450.19 feet and to a set 5/8 inch iron pin at the Southwest corner of the Northeast quarter of said Northeast quarter of Section 17, passing a set 5/8 inch iron pin at 10.25 feet; thence with the South line of the North one half of said Northeast quarter and running North 88 degrees 46 minutes 52 seconds West for 1322.28 feet and to a set 5/8 inch iron pin marking the Southwest corner of said North one half of the Northeast quarter; thence North 00 degrees 27 minutes 08 seconds East for 1324.61 feet and to the point of beginning. Containing 75.429 acres, more or less.

Subject to, all legal highways and rights of way of record.

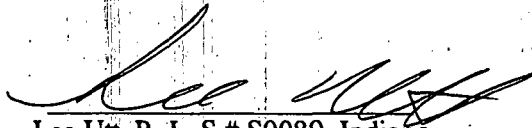
Lee Utt, R. L. S.# S0089, Indiana
1604 South Henderson St.
Bloomington, Indiana 47401
September 6, 1999

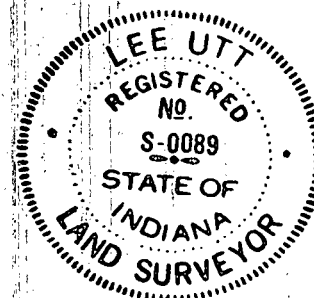

LEE UTT
Registered Land Surveyor No. 50089, Indiana
Phone 332-6366
1304 S. Henderson Street
Bloomington, Indiana 47401

SURVEYOR'S REPORT

Carl & Autumn Gilliland
Section 17, Township 8 North, Range 2 West, Monroe County, Indiana
September 8, 1999

1. In accordance with Title 864, Article 1.1, Chapter 13, Section 1 through 34 of the Indiana Administrative Code, the following observation and opinions are submitted regarding the various uncertainties in the location of the lines and corners established on this survey as a result of

- a) Variances in the reference monuments
- b) Discrepancies in record descriptions and plats;
- c) Inconsistencies in lines of occupation;
- d) Random error in measurements (theoretical uncertainty)

The theoretical uncertainty (due to random errors in measurements) of the corners of the subject tract established this survey is within the specifications for a Class C. survey (0.50), as defined in IAC864.

The subject tract is a compilation of smaller tract of land that are described in documents obtained from public records. There is a found iron pipe 10.66 feet North of a set 5/8 inch iron pin set this survey to mark the Northeast corner of Section 17, Township 8 North, Range 2 West. The found iron pipe has been observed at other times in the process of other surveys but was determined by me to not be marking the section corner. There are nails in nearby trees which seem to represents ties to the existing iron pipe. However a check with the Monroe County Surveyor office failed to validate this iron pipe as marking a corner. A 5/8 iron pipe was set at the Northwest corner of the Northeast quarter of Section 17. An iron pipe at an existing fence corner was found 37 feet North and 8 feet West. A 5/8 inch iron pin was set at the Northwest corner of the Northeast quarter of the Northeast quarter of Section 17. 19 feet South of an East-West fence line. A 5/8 inch iron pin was set on the North line of Section 17 at the Northerly corner in a North-South fence line and 13 feet South of East-West fence line. A 5/8 inch iron pin was set at the most Northeasterly corner of the subject tract and 15 feet West of the East line of Section 17 and 32 feet South of existing East-West fence line. A 5/8 inch iron pin was set at the Southwest corner of the Northeast quarter of the Northeast quarter of Section 17 and in an Old road bed 15 feet South of the East -West fence line. A 5/8 inch iron pin was set to mark the Southwest corner of the North One half of the Northeast quarter of Section 17, 6.2 feet North and 7 feet West of a fence corner east-west-north.

Control this survey and the basis of bearings are from the previous survey, done by Lee Utt in the area.

Monuments were either found or set as shown on the plat of survey.

As a result of the above observation, it is my opinion that the uncertainties in the location of the lines and corners are compatible with the standard of accuracy as stated above.

Lee Utt, R.L.S. # S0089, Indiana
1604 South Henderson St.
Bloomington, Indiana 47401



Section Corner - Tied off

Van Buren Twp Gr 09
Whitehall Quad US G. S. map

found - $\frac{5}{8}$ " rebar w/cap
"UTT S-0089"


referenced Gilliland survey
by Lee UTT

Station	bearing	hor dist	tree dbh	description
A	-	-	$\frac{5}{8}$ "	rebar
B	S75°W	2.09	17"	white oak
C	N57°W	9.86	8"	sugar maple
D	N08°W	38.17	$1\frac{3}{8}$ "	crimped pipe
E	S81°E	28.68	16"	white oak

Survey Marker pt. C - 5 ft height

7.

pt A - $\frac{5}{8}$ " rebar w/cap February 10, 2000
pt B - MAG nail in tree T8 N R 2 W sec. 17 N 4
pt C - MAG nail in tree Temp - 45° drizzle
pt D - crimped iron pipe - 10:30 am
pipe $1\frac{3}{8}$ " along crimp Kerin Fennight
pt E - MAG nail in tree Corbin Baird

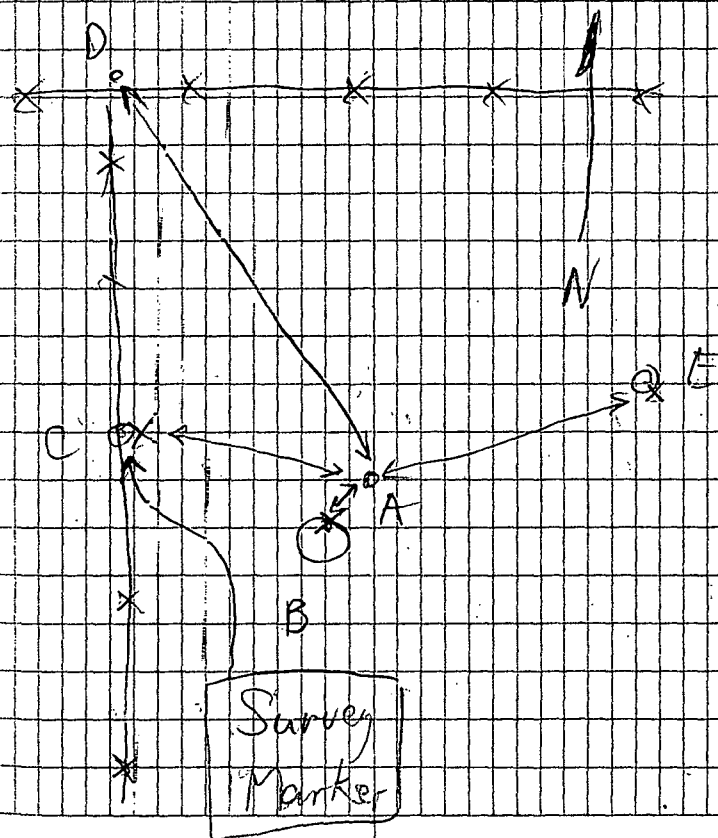

Section Corner - tied off
Van Buren Twp E-09
White Head Quad USGS map

Found - $1\frac{1}{2}$ " iron pipe w/ flanging
orange & blue & white

referenced	Gilliland Survey				
by Lee Utt					


Stat


	Station	bearing	hor dist	tree dbh	descriptions
A					
B					
C	A	—	—		
D	B	N58°W	17.40	24"	sugar maple
E	C	N17°W	19.55	15"	sugar maple
	D	S75°E	69.72	15"	power pole
	E	S35°E	31.55		edge of pavement
	F	N90°W	16.67	nail	w/ply. = Pile


Survey Marker pt B 4ft height

8

p1A - 1/2" iron pipe February 10, 2000
p1B - PK nail in tree T&N R. 2w Sec 17 ENE
p1C - MAG nail in tree Temp - 45° cloudy
p1D - MAG nail in pole Time - 11:30 am
p1E - edge of blacktop Kevin Enright ✓
p1F - nail w/ blue Corbin Baird P
Flagging

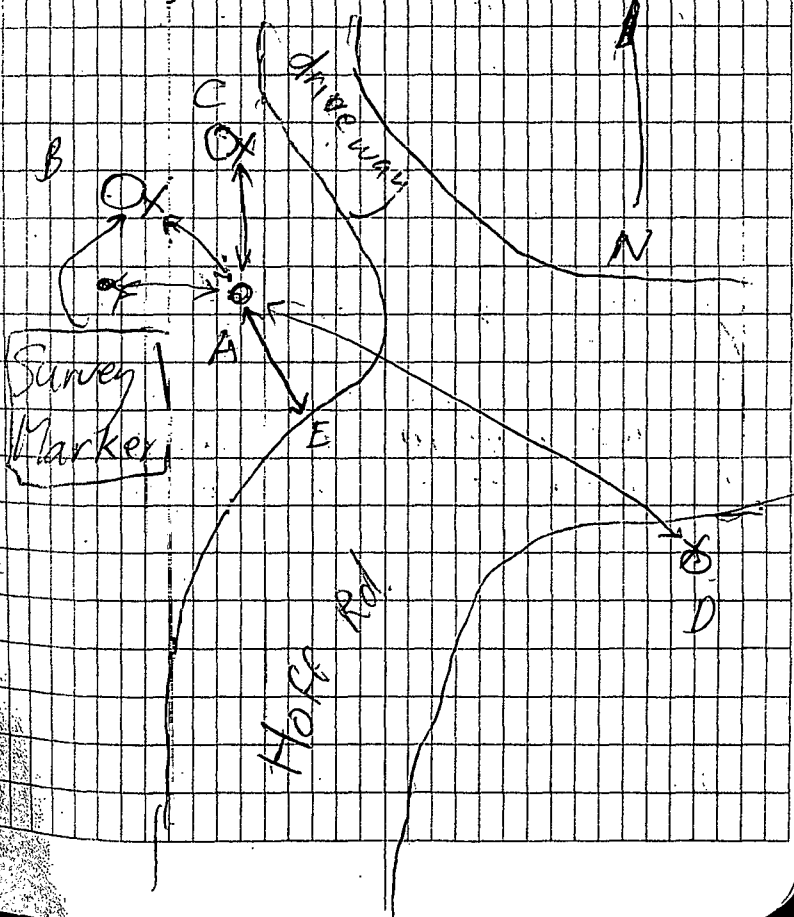

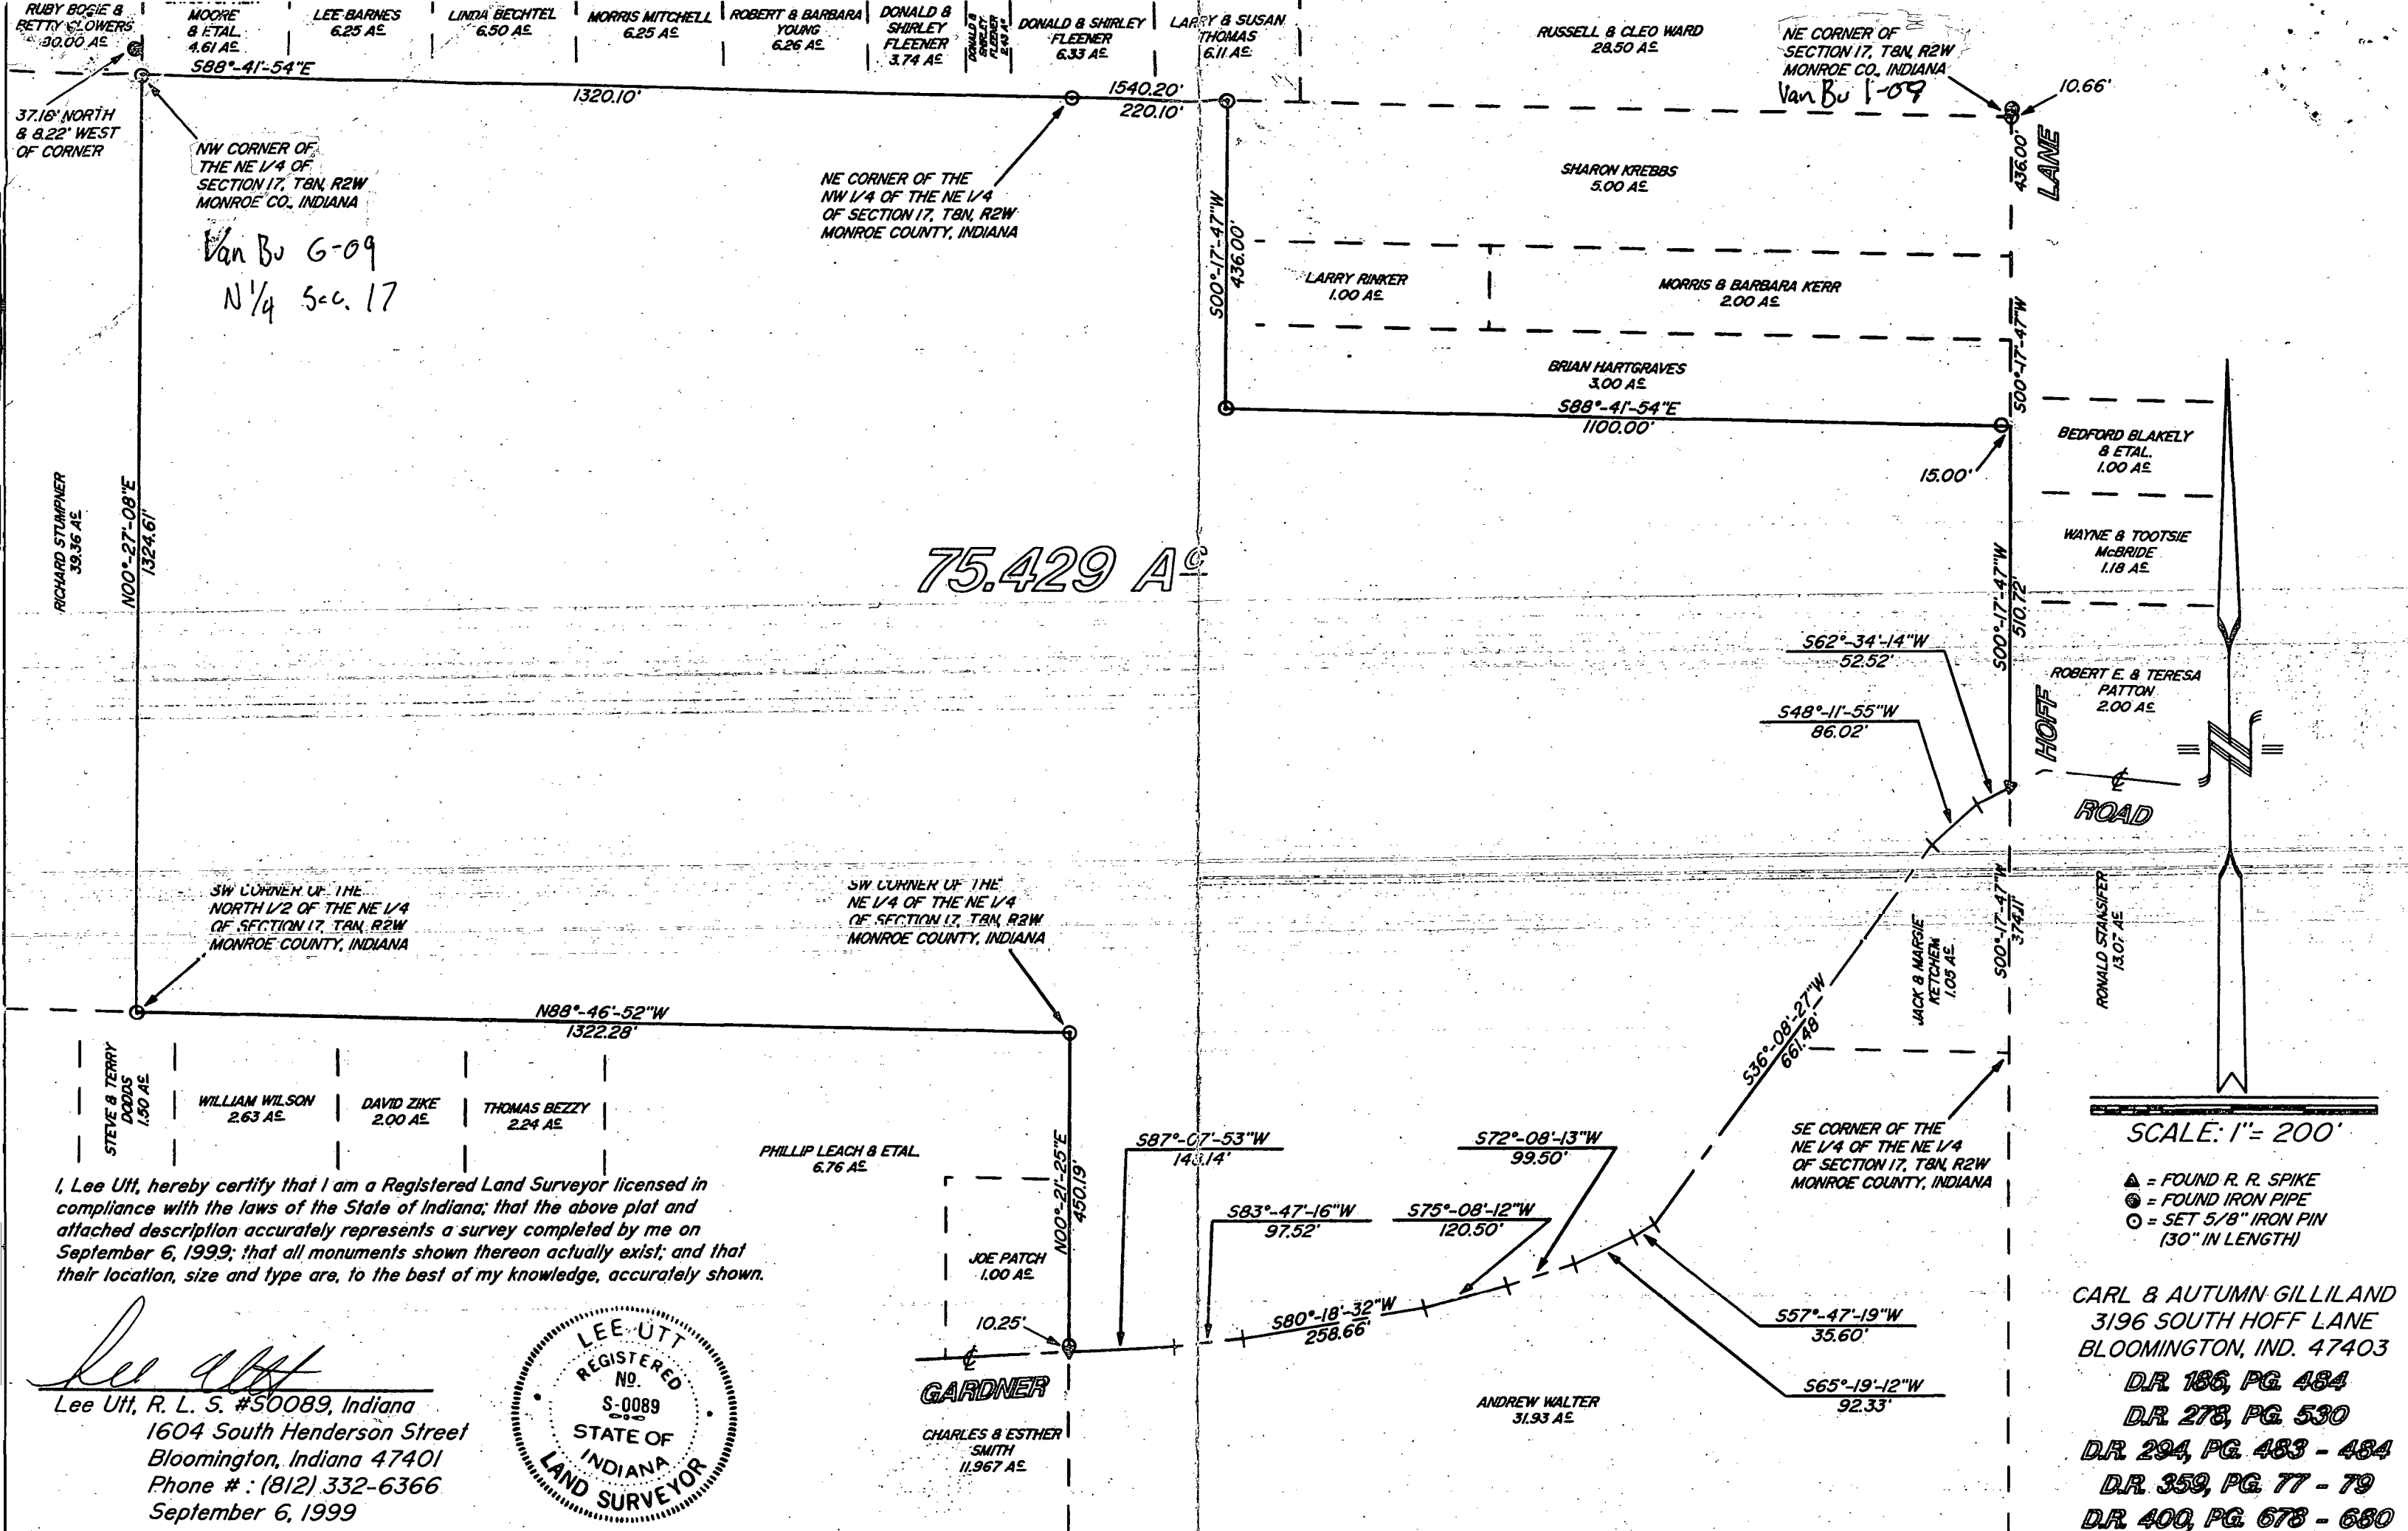

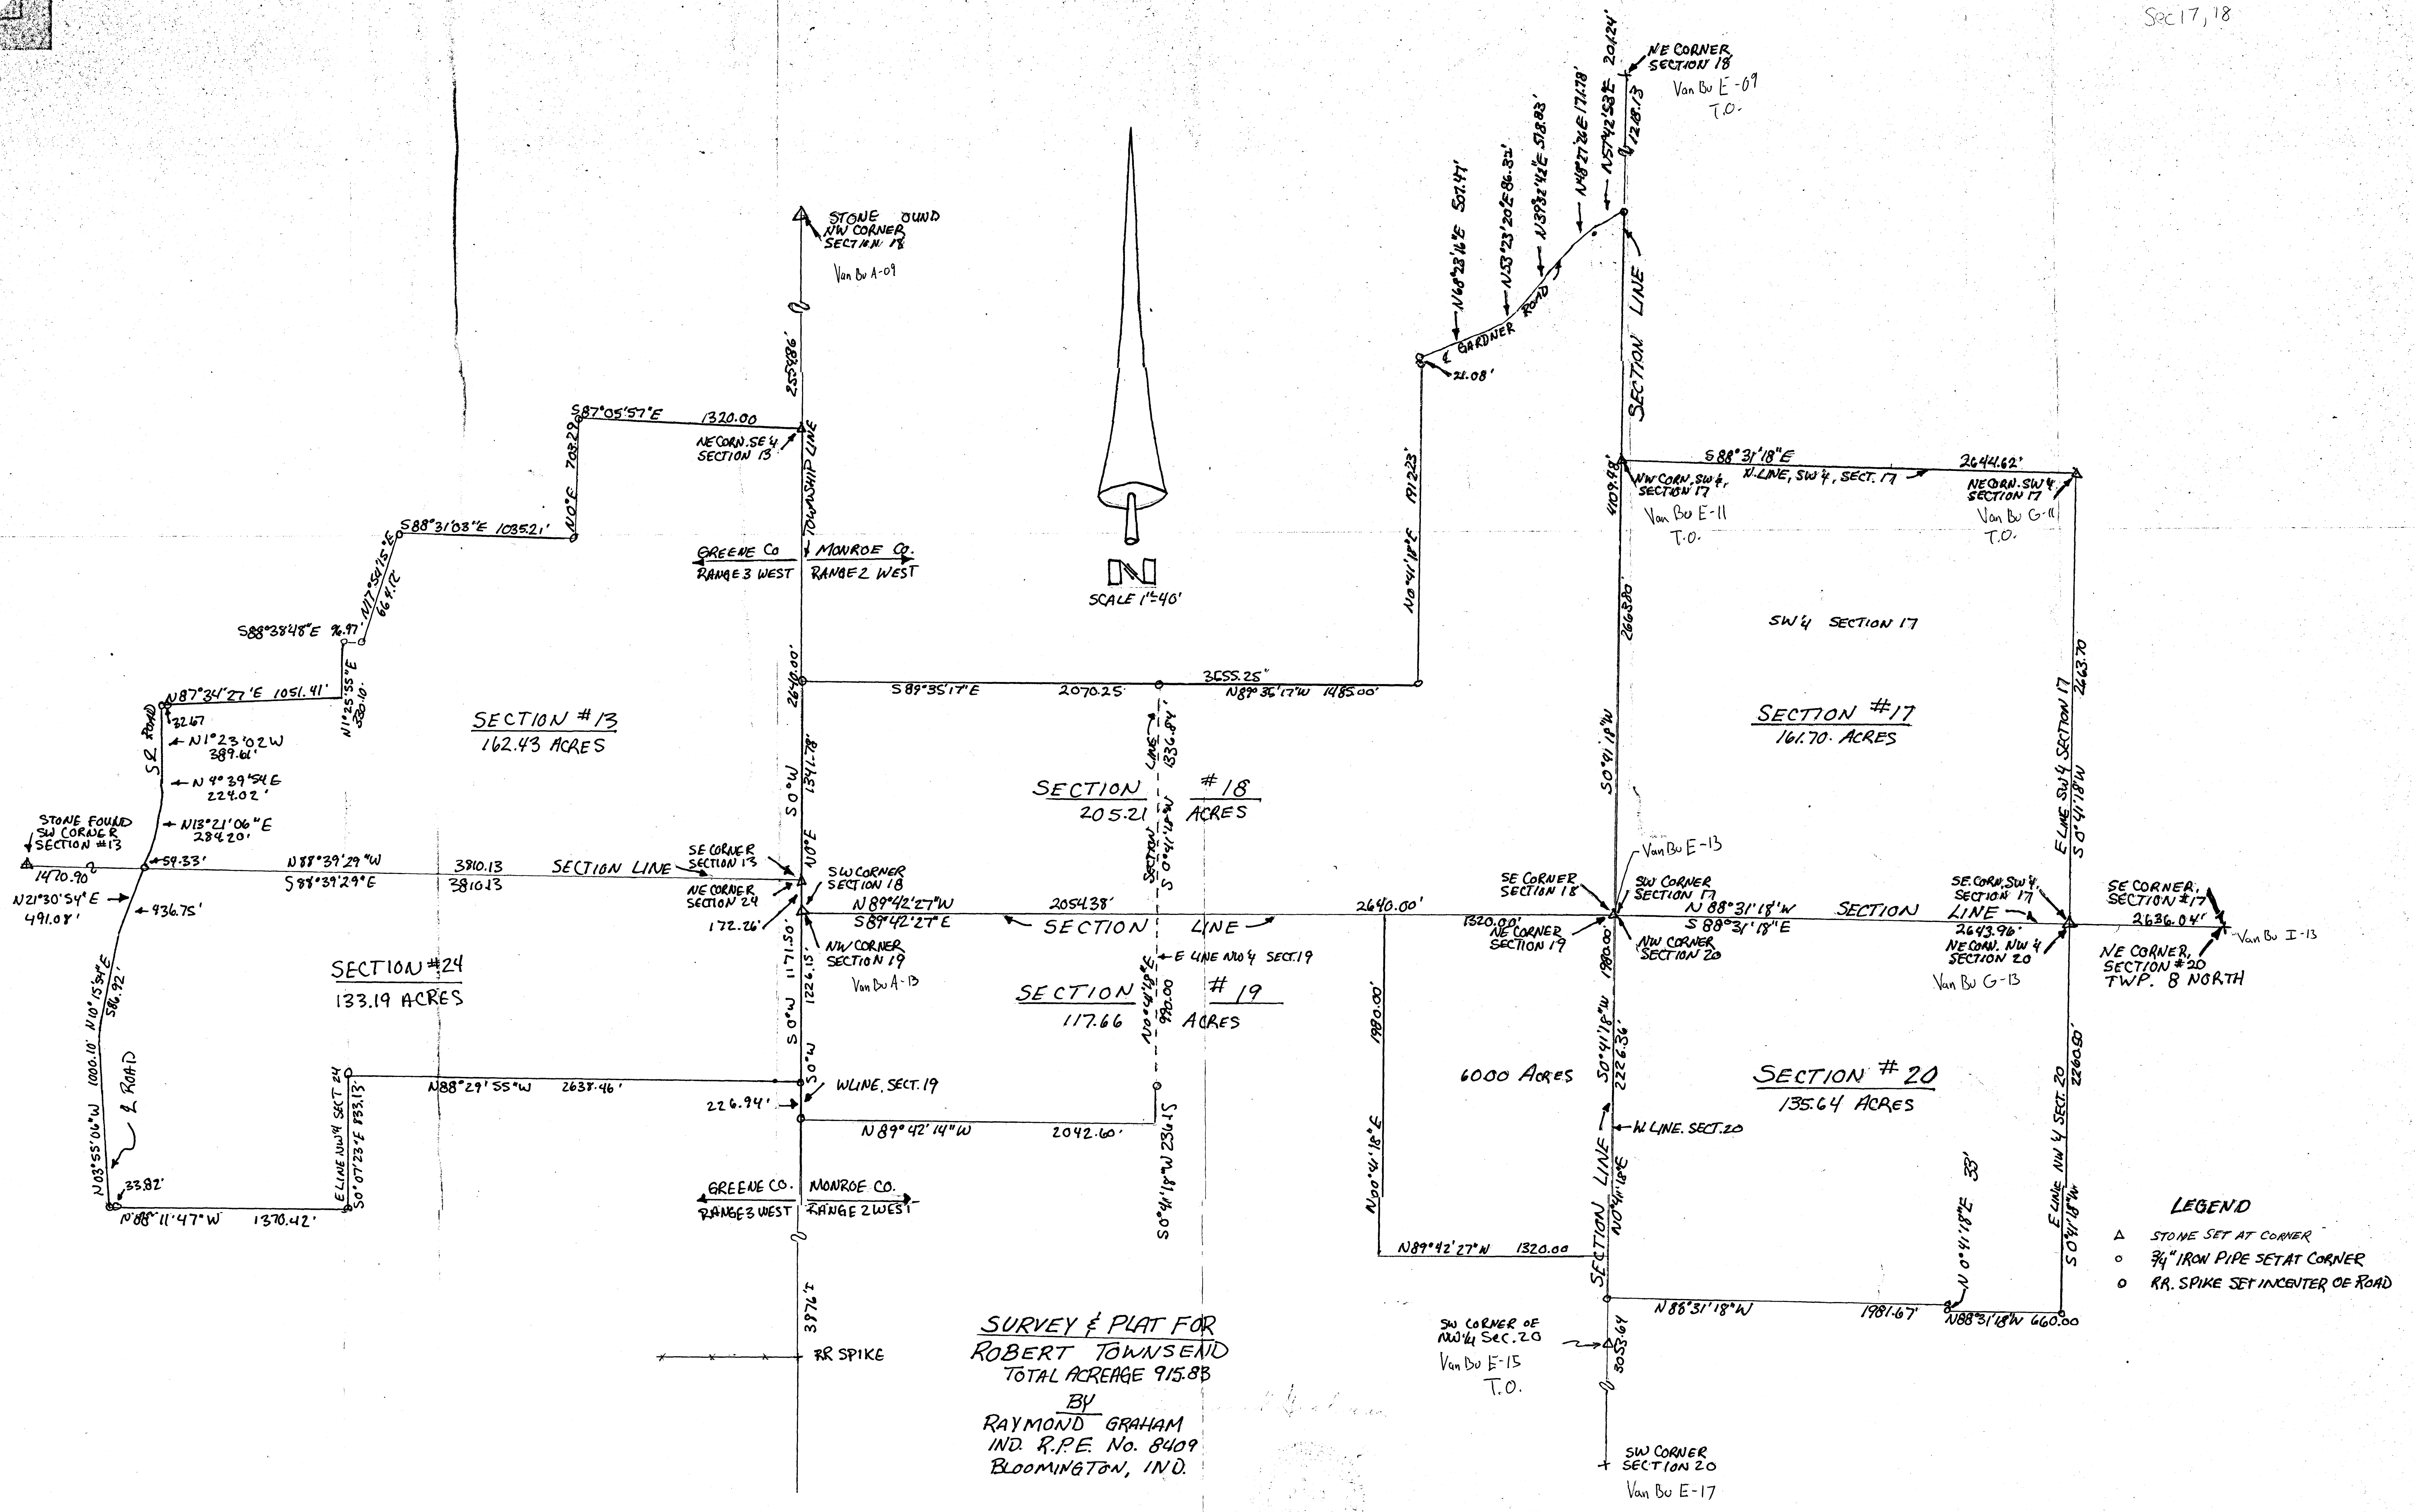

LEGEND

- △ STONE SET AT CORNER
- 3/4" IRON PIPE SET AT CORNER
- RR SPIKE SET IN CENTER OF ROAD

48½° E 36 lbs distant Buck 6 inches in diameter N 34° E 32 lbs
New witnesses made at the ½ mile post of Section 2 T
10 R 1 E W Oak 24 inches in diameter S 37° E 26 lbs dist
Chain bearers John Moore and Jacob Adkins sworn
This march 16th A D 1834

Trust 800
Rec. 700
Dm 100

James W Spencer
Monroe County Surveyor

March 17th 18th A D 1834

Surveyed Section 14 T 8 R 2 W
+ established the following corners Viz The NW corner of the
Section wit trees W Buck 3 N 46½° E 8 lbs Sugar 8 N 81° W 7 lbs
N.E. corner of NW gr of NW gr Sugar 8 S 12 E 21 W Walnut 16 W 18
The S.W. cor of NW gr of NW gr Hickory 12 S 29 W 48 Buck 16 N 16 W 10
The S.E. cor of NW gr of NW gr Sugar 20 S 12 E 14 Buck 14 S 20 W 18
The S.W. cor of SE gr of SE gr gum 12 N 45 W 17 W Oak 12 N 47 E 18
The S.E. cor of SE gr of SE gr Elm 20 N 18 W 21 W Oak 8 S 37 E 33
The S.E. cor of SE gr of SE gr W Oak 12 N 50 W 25 W Oak 16 N 58 E 16
The S.W. cor of SE gr of SE gr Hickory 10 N 25 W 15 Maple 10 S 81 W 29
Center of Section Hickory 10 S 46 W 11 gum 20 S 9 W 80
The S.W. cor of NW gr of SE gr W Oak 20 S 11 W 23 Hickory 12 West 21
The S.E. cor of NW gr of SE gr Hickory 10 N 25 E 25 Hickory 12 S 63 W 14
The S.E. cor of SE gr of SE gr W Oak 20 N 80 E 16 Dogwood 8 S 26 W 18
The S.W. cor of SE gr of SE gr W Oak 20 corner tree
The S.E. cor of SE gr of SE gr Buck 18 S 42 E 13 Dogwood 3 S 79 E 20
The S.W. corner of Section W Walnut 4 N 73 E 35
The S.E. cor of SE gr of SE gr Hickory 12 N 60 W 28 Dogwood 8 N 82 E 40
George Eller }
Riley Adkins } ch br

James Woodburn
Deft Surveyor

April 11th 1834

Established a corner in the center of Section 21 T 10
R 2 W for Eli Abernathy + there wit trees Buck 8 S 19 W 7 lbs dist
Dogwood 4 S 34 E 6
James Woodburn
Deft

April 1834

Surveyed in Section 20 T 10 R 2 W for Bowman
Stine + others and established the following corners
Viz The N.E. cor of E ½ of NW gr wit trees Buck 20 N 59 W 8 lbs
Buck 6 S 45 E 25 ½ "
The S.W. cor of E ½ of NW gr " Buck 10 S 78 E 37 "
Buck 8 S 64 E 71 "
The NW cor " " " " B Walnut 10 S 82 E 113 "
Cherry 2 S 40 E 14

48½° E 36 lks distant Beech 6 inches in diameter N 34° E 32 lks
New witnesses made at the ½ mile post of Section 2 T
10 R 1 E W Oak 24 inches in diameter S 37° E 26 lks dist
Chain bearers John Moore and Jacob Adkins Sworn
This march 16th A D 1834

Tree 800
Rec. 700
Dm 100

James W. Spencer
Monroe County Surveyor

March 17 & 18th A D 1834

Surveyed Section 17 T 8 R 2 W
+ established the following corners viz The NW corner of the
Section wit trees W Beech 8 N 46½° E 8 lks Sugar 8 N 81° W 7 lks
N.E. corner of NW gr of NW gr Sugar 8 S 12 E 21 W Walnut 16 W 18
The S.W. cor of NW gr of NW gr Hickory 12 S 29 W 43 Beech 16 N 16 W 10
The S.E. cor of NW gr of NW gr Sugar 20 S 12 E 14 Beech 14 S 20 W 18
The S.W. cor of NE gr of NE gr gum 12 N 48 W 17 W Oak 12 N 49 E 18
The S.E. cor of NE gr of NE gr Elm 20 N 18 W 21 W Oak 8 S 37 E 33
The S.E. cor of S.E. gr of NE gr, W Oak 12 N 50 W 25 W Oak 16 N 88 E 16
The S.W. cor of S.E. gr of NE gr Hickory 10 N 25 W 18 Maple 10 S 81 W 28
Center of Section Hickory 10 S 46 W 11 gum 20 S 9 W 30
The S.W. cor of NW gr of S.E. gr W Oak 20 S 11 W 23 Hickory 12 West 21
The S.E. cor of NW gr of S.E. gr Hickory 10 N 28 E 25 Hickory 12 S 65 W 14
The S.E. cor of NE gr of S.E. gr W Oak 20 N 80 E 16 Dogwood 8 S 26 W 18
The S.W. cor of S.E. gr of S.E. gr W Oak 20 corner tree
The S.E. cor of S.W. gr Beech 18 S 42 E 15 Dogwood 3 S 79 E 20
The S.W. corner of Section W Walnut 4 N 75 E 38
The S.E. cor of S.W. gr of NE gr Hickory 12 N 60 W 28 Dogwood 3 N 82 E 40
George Eller }
Kaly Adkins } ch br

James Woodburn
Deft Surveyor

April 11th 1834

Established a corner in the center of Section 21 T 10
R 2 W for Eli Abernathy & others wit trees Beech 8 S 19 W 7 lks dist
Dogwood 4 S 34 E 6

James Woodburn
Deft

April 1834

Surveyed in Section 20 T 10 R 2 W for Bowman
Stine & others and established the following corners
viz The N.E. cor of E ½ of S.W. gr wit trees Beech 20 N 59 W 7 lks
Beech 6 S 45 25½ " "
The S.W. cor of E ½ of S.W. gr " Beech 10 S 78 E 37 " "
Beech 8 S 64 E 71 " "
The NW cor " " " " B Walnut 10 S 85 E 113 " "
Cherry 2 S 40 E 54

Survey in Section 31 T. 9, R. 1, E for Harvey Smith
 Ren Smith and David Hunter, performed on the 7th day
 of March 1876 commenced at a stone heretofore established
 80 Poles North of S.W. corner of said section and ran N⁸W
 159 Poles & links. To Stone corner heretofore established, established
 a corner at western $\frac{1}{2}$ mile post by consent of parties they
 being present and agreeing to the same witnessed by Red Oak
 20 inches in diameter So 40° E 26 links distant, also white Oak
 8 inches in diameter N 48° W 19 $\frac{1}{2}$ links (old witness trees gone)
 Chain bearers Ren Smith & Wm Smith. S. Magman Harvey Smith

M. C. Buskirk Deputy

August The 28th 1876

Met according to previous notice duly served according
 to law in M. Blain, Hugh Sample Mrs. Gardner & Thacker
 William Foster William Turner William Brown and William May
 at the North East corner of section 17 Town 8 North Range 2 West
 and made the following survey. Ran west (via $4^{\circ} 20'$)
 79.85 ch missed the N.W. sec corner 150 links to the south
 Went back and corrected and established the north half
 mile post by setting a stake witnessed by Mulberry 8 in N 80° W
 9 links Sugar 12 in N 81° E - 35 L Thence south (via $4^{\circ} 45'$)
 20.00 ch established corner wit: Dogwood 4 in N 47° E - 4 $\frac{1}{2}$ L
 Sugar 10 in N 81° E - 12 Ls Milton C. Isom and
 Isaac F. Eller Chain bearers Sworn Notice in file
 in the Surveyors Office this the 28th day of August 1876.

W. C. Surveys